

RECEIVED


NOV 27 1987

T. 38 S., R. 8 W., W.M.

WATER RESOURCES DEPT.  
SALEM, OREGON

T-6052

App 69434 Per 50373  
Unnamed Spring, Trib Deer Cr.  
154'S & 562' W from W 1/4 Cor Sec 15  
Dom incl. L&G  
Priority Oct 29 1987

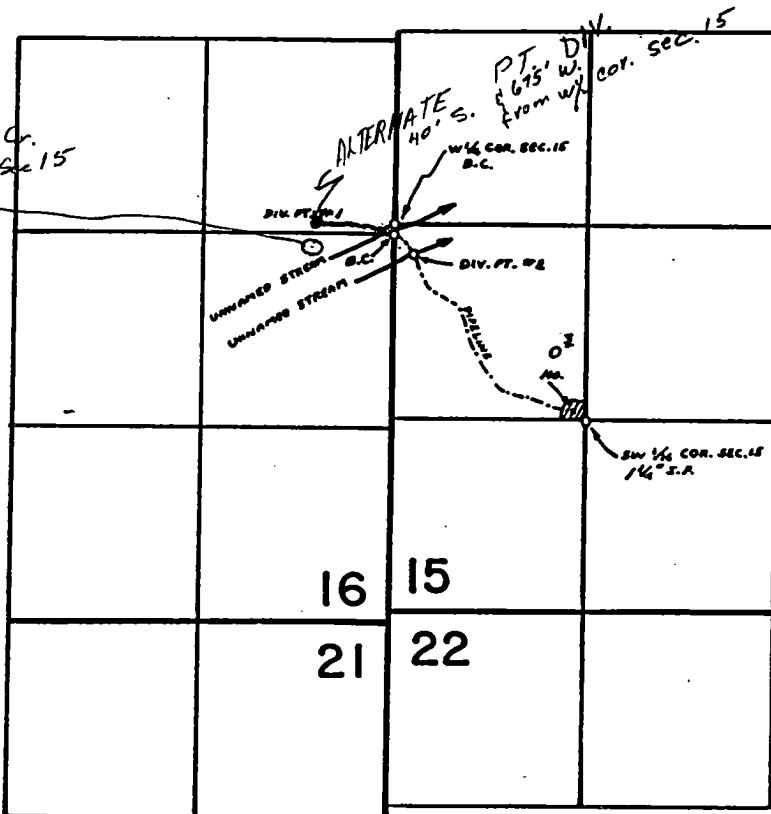

DIV. PT. #1 : 40'S & 40' W FROM W 1/4 COR. SEC. 15

DIV. PT. #2 : 200'S & 130' E FROM W 1/4 COR. SEC. 15

RECEIVED

DEC 17 1986

WM. DIST. 14  
GRANTS PASS, ORE.

### FINAL PROOF SURVEY UNDER

Application No. 49543 Permit No. 37081  
IN NAME OF

PHILIBERT CONSTANT SEYDEL

Surveyed JUL. 28 1978 by B. SUND  
NOV. 7 1984 J. R. WOODROOF

P.T.S. - 1978 - 14 - C  
41033-170-270 R