


PROPERTY OF RICHARD R. KLINGENBERG

**RECEIVED**  
AUG 4 1972  
STATE ENGINEER  
SALEM, OREGON

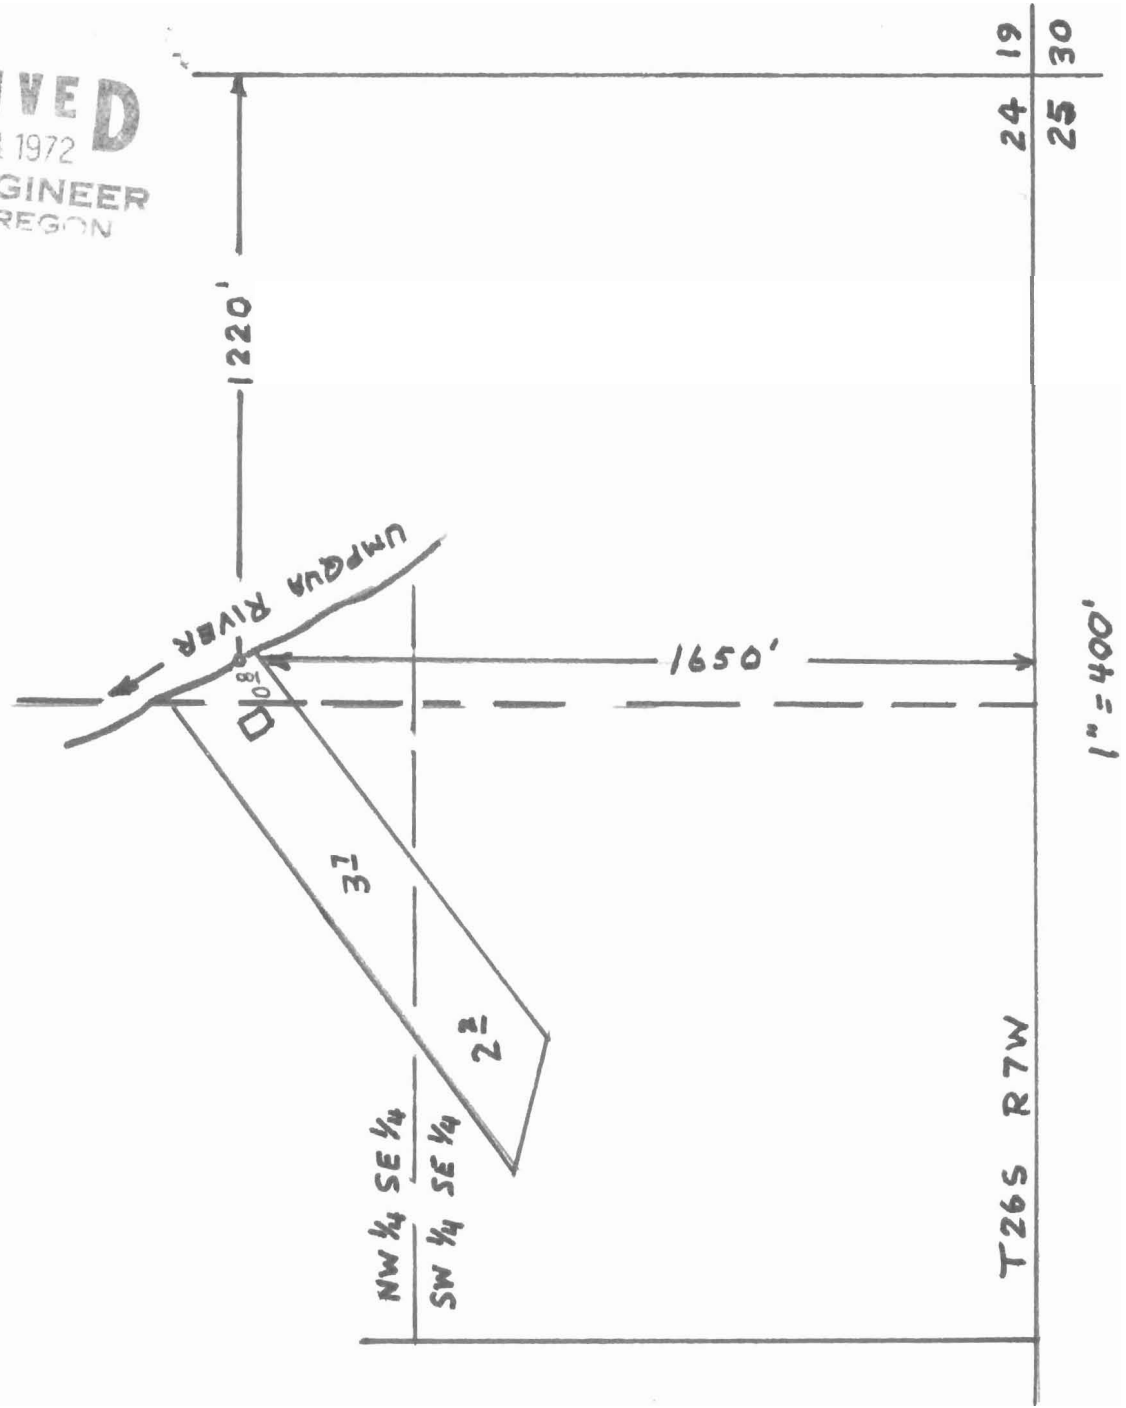

Application No. 49547  
Permit No. 37085