T. 24 S. R. 7 W. SEC. 13

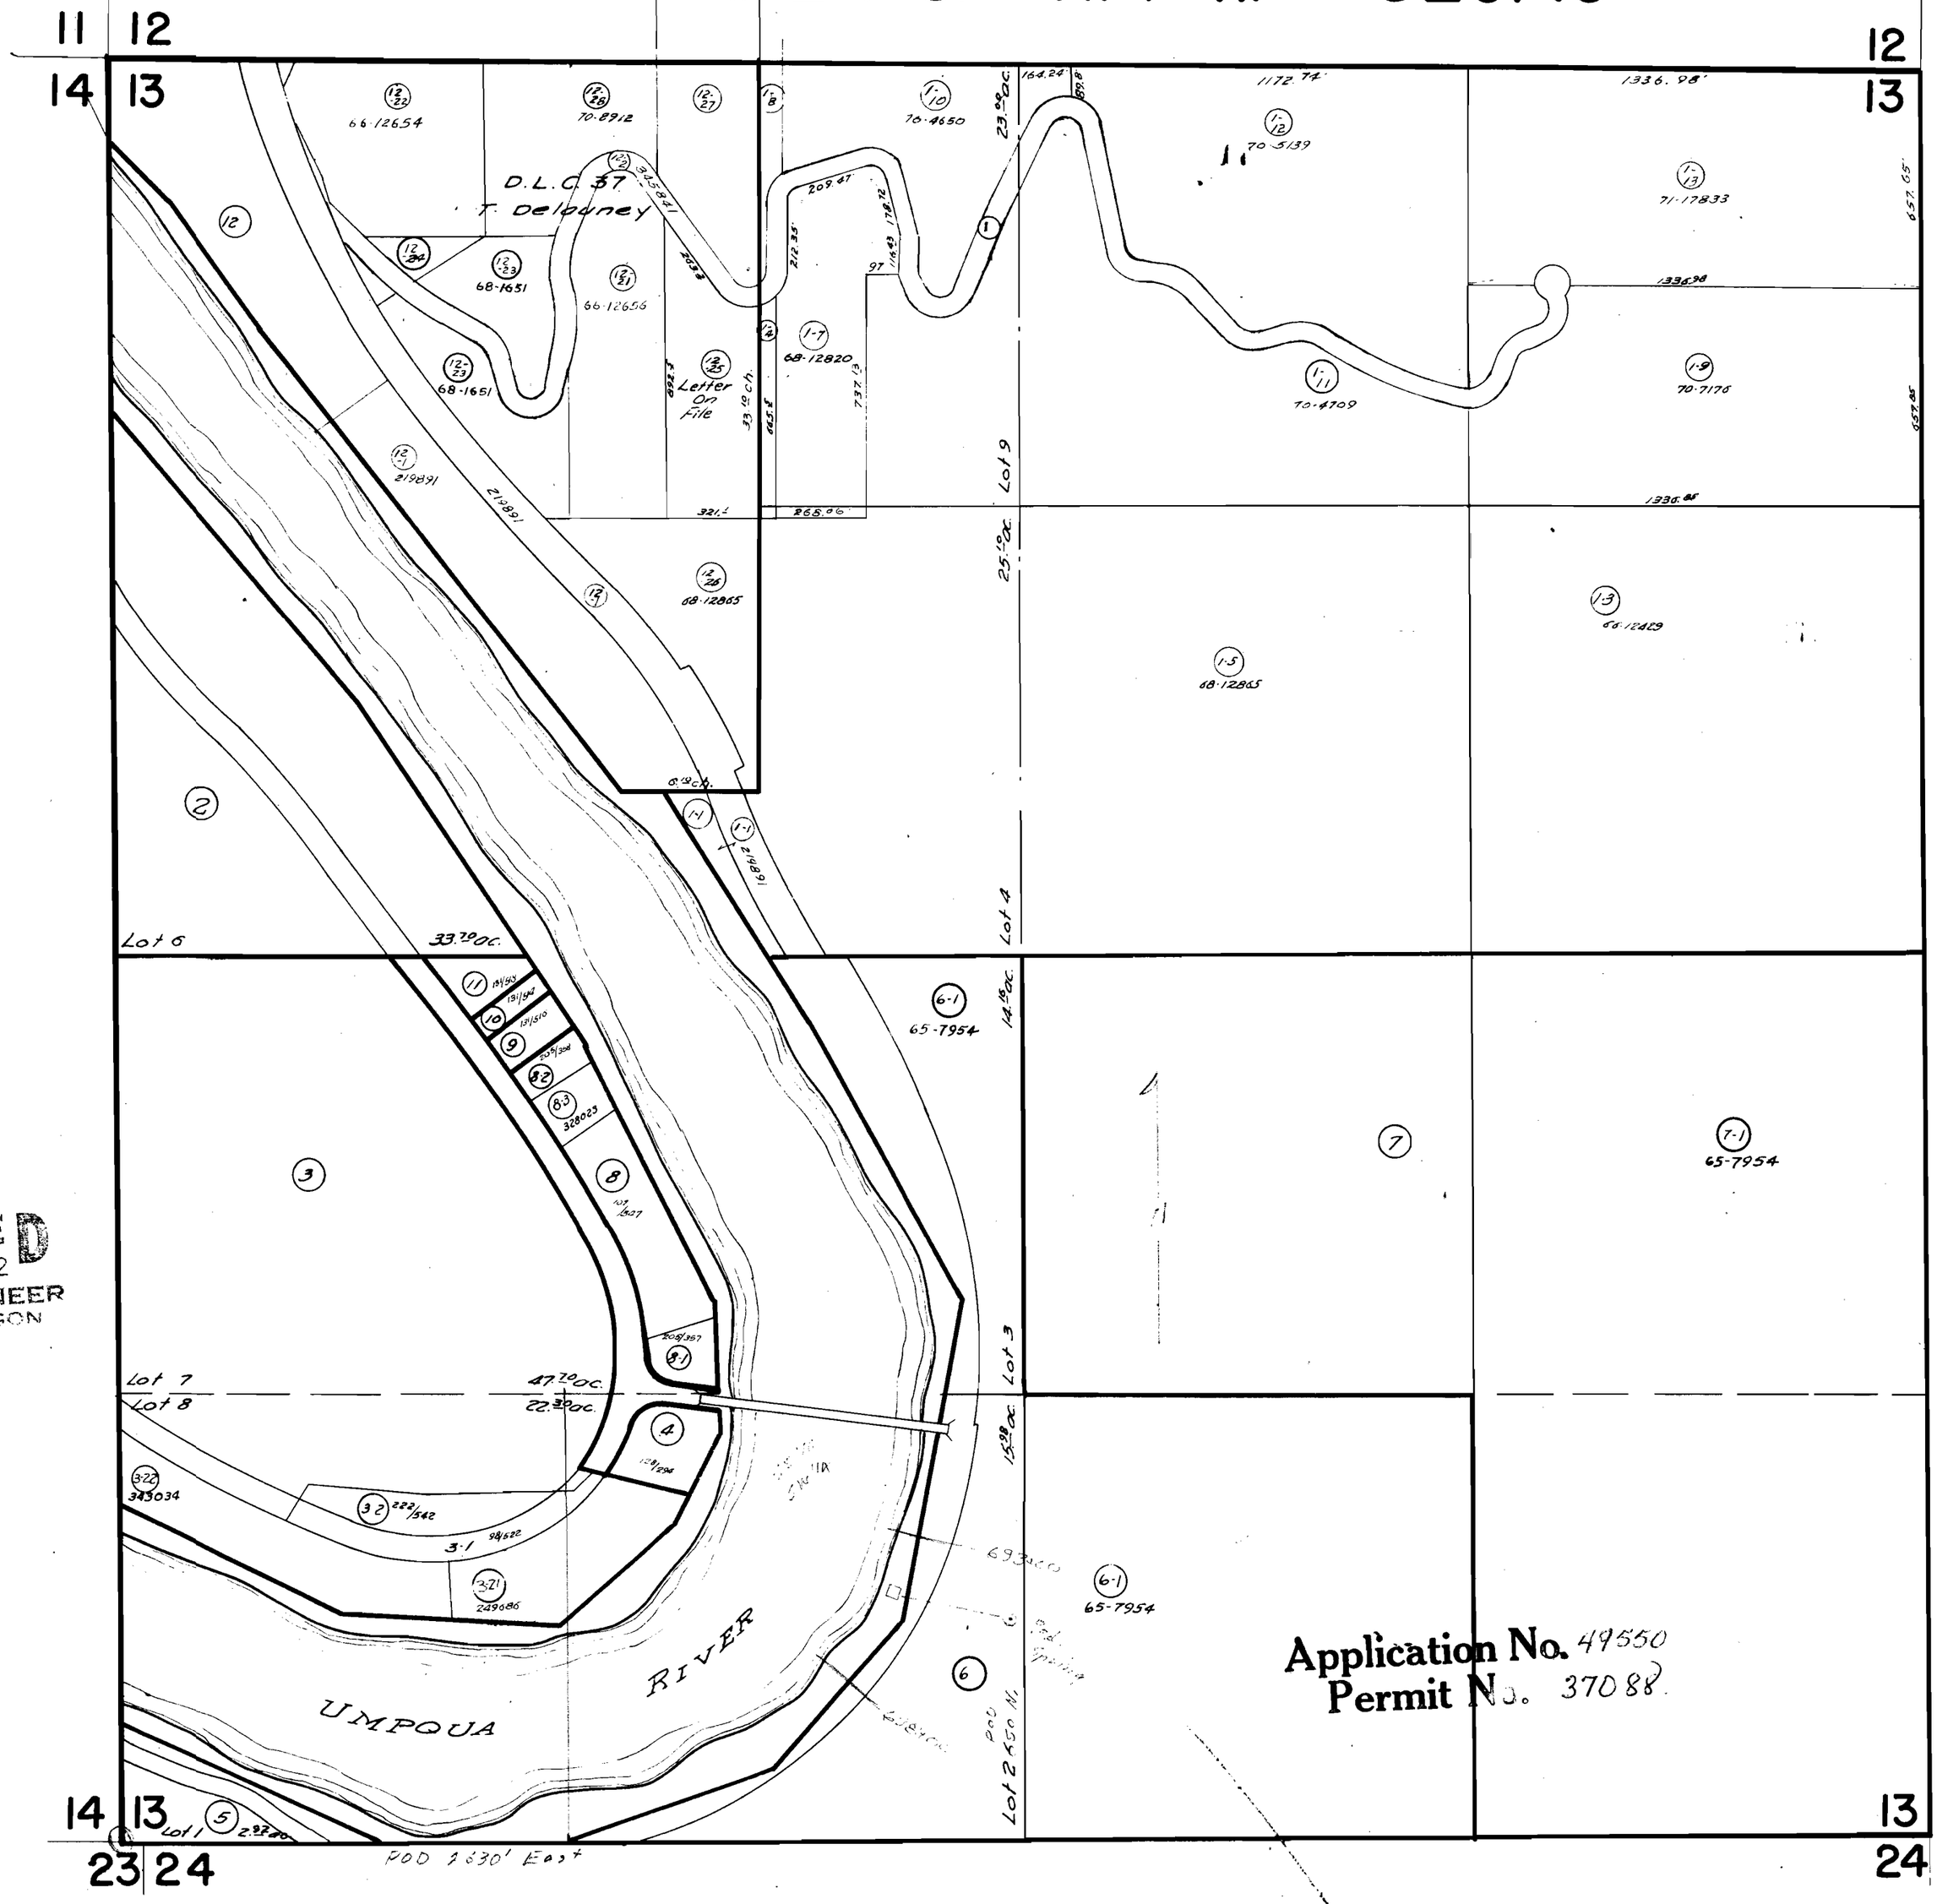

RECEIVED
AUG 4 1972
STATE ENGINEER
SALEM, OREGON

Application No. 49550
Permit No. 37088