

4498
S.E. 1/4 NE 1/4

Expect to irrigate 15 acres.

XXXXXX


Dec. 30

Township 36 South,

Range 4 West W.M.


Little Savage Creek source of supply - X' point of diversion - head of ditch - water led west along south line of SE 1/4 NE 1/4

2577

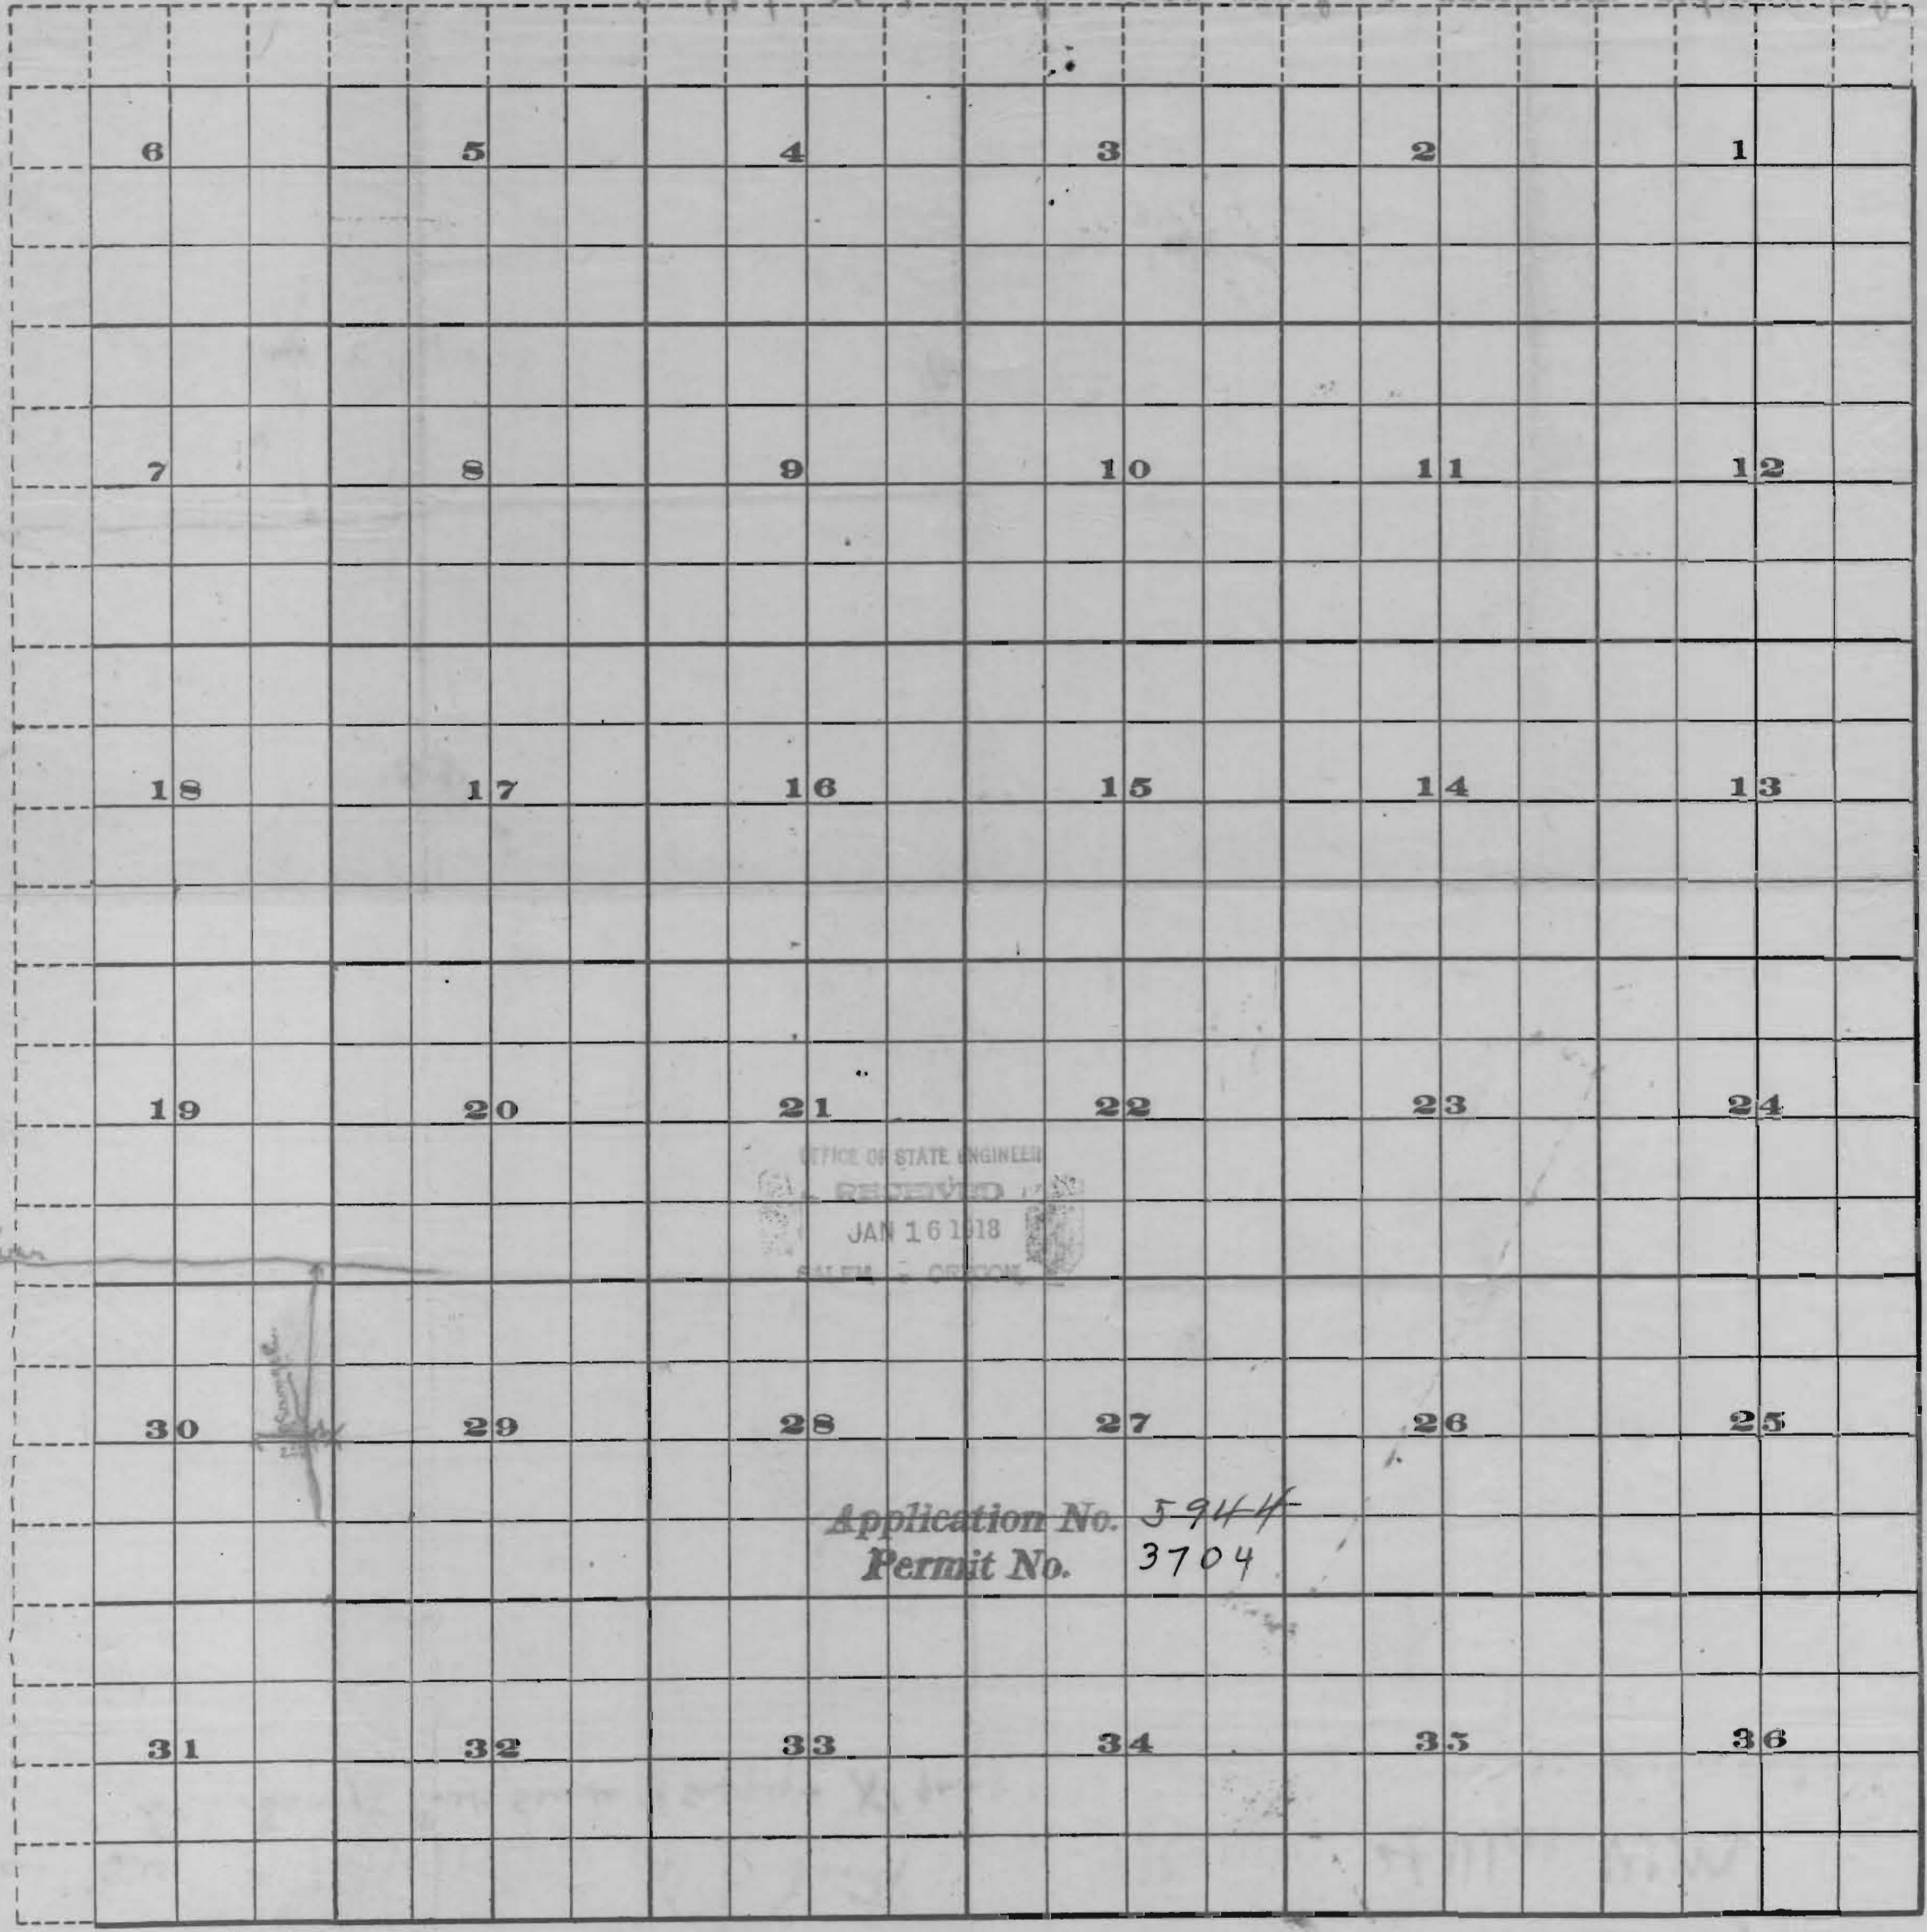

OFFICE OF STATE ENGINEER
 RECEIVED
 JAN 16 1918
 SALEM, OREGON

Application No. 5944
 Permit No. 3704

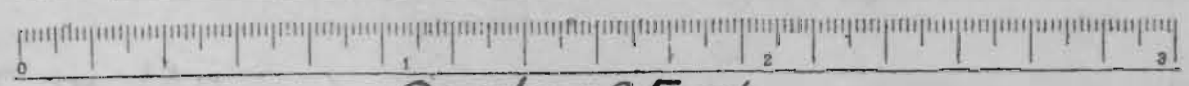

Scale of Feet.

2577