


T. 35 S., R. 6 W., W.M.

RECEIVED

OCT 8 1980

WM. DIST. 14  
GRANTS PASS, ORE.

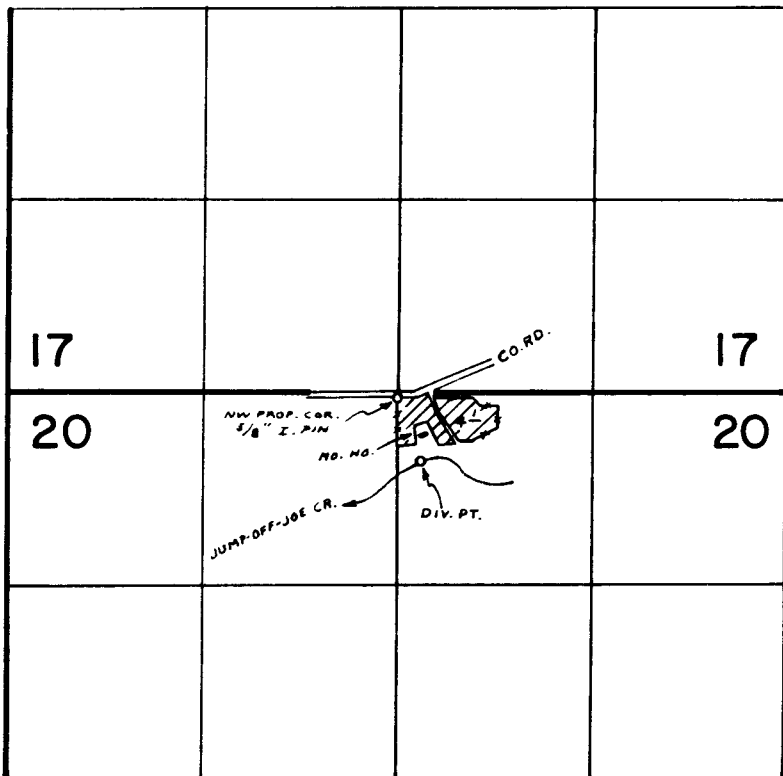

DIV. PT. LOC.: 480' S. & 160' E FROM N 1/4 COR. SEC. 20

**FINAL PROOF SURVEY**  
UNDER

*Cert-49539*

Application No. 49560 Permit No. 37094

IN NAME OF

JOHN C. & EDITH A. STILLMAN

Surveyed NOV. 2 77, by B. SUND

P.T.S. - 1977-14-B