


Application No

T. 40 S. R. 1 W. W.M.

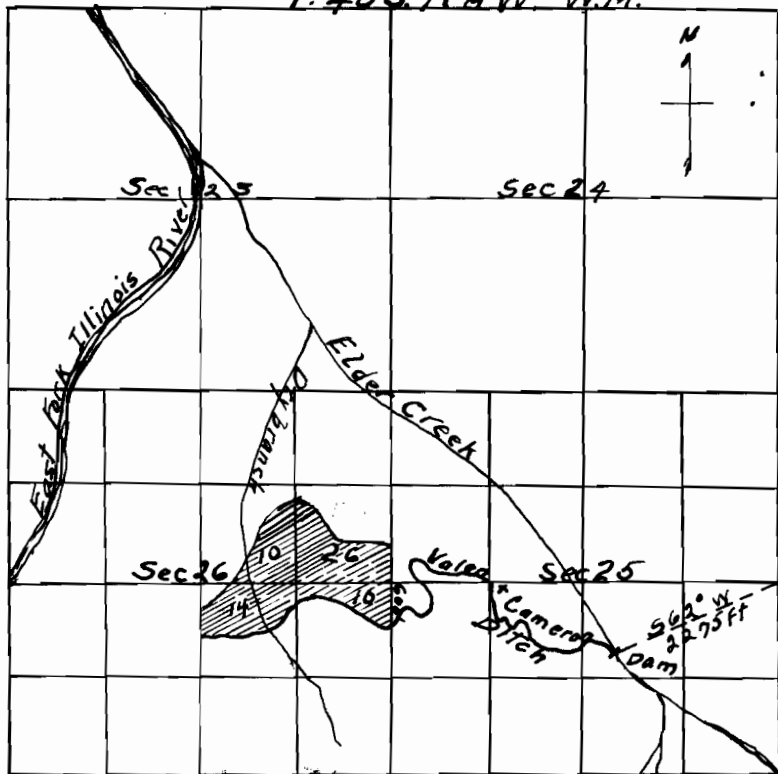

No. 5991

3713