

RECEIVED
JUL 30 1973
STATE ENGINEER
SALEM, OREGON

Polk County
T8S R6W WM
Scale 1" = 400'

10


NW SW

Lot 7

SW SW

Lot 8

9 10
16 15

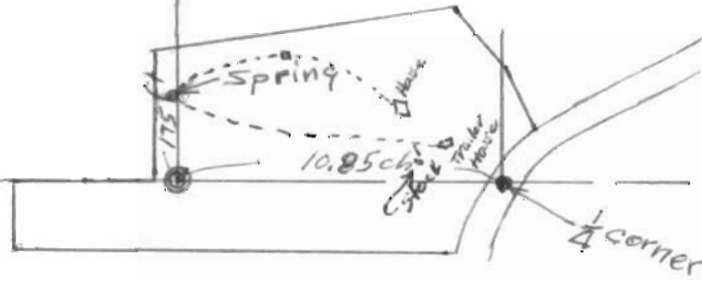

Application No. 50964
Permit No. 37142