


RECEIVED
SEP 28 1972
STATE ENGINEER
SALEM OREGON

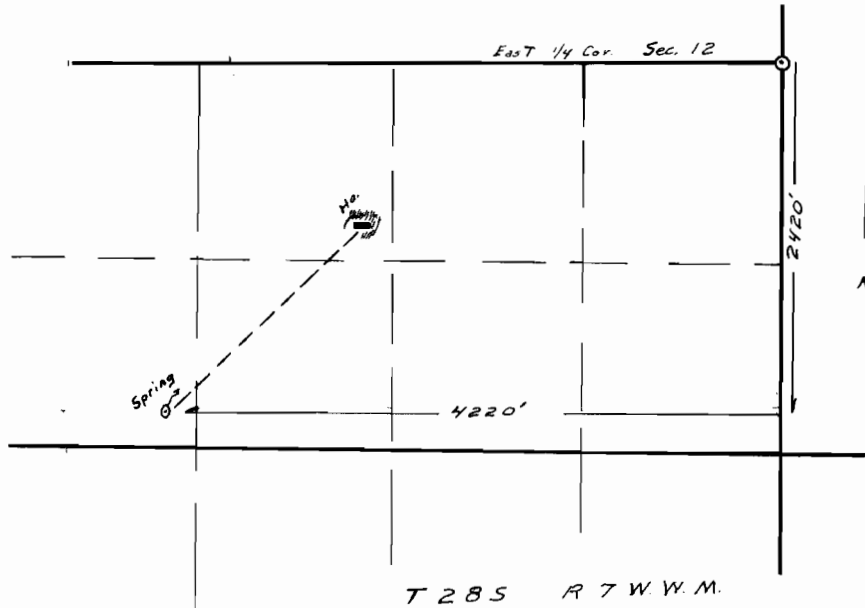

4" = 1 mile

Application No. 49742
Permit No. 37250