



T 4 N R 8 W
CLATSOP COUNTY, OREGON
BK 251 P 198 Deed Records
Scale 1" = 100'

Application No. 49763
Permit No. 37259

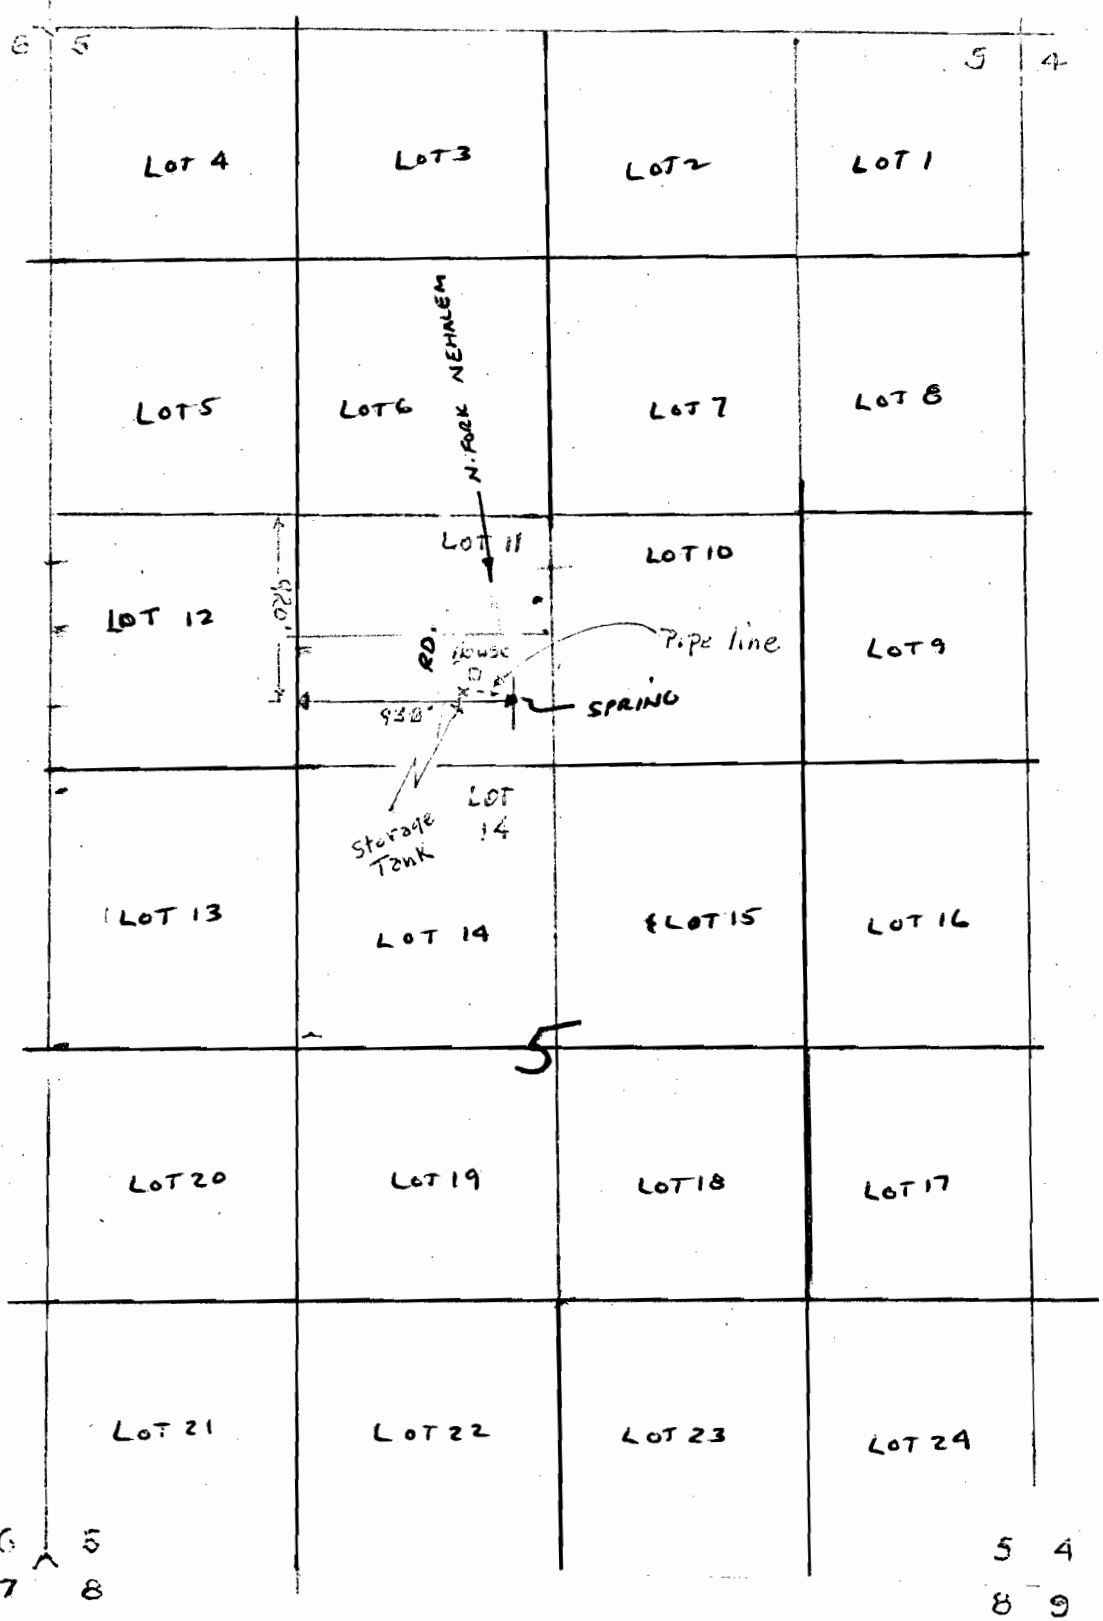

T4N R8W
 CLATSOP COUNTY, OREGON
 BK 251 P198 Deed Records
 Scale 1"=1000'

Application No. 49763
 Serial No. 37259