


Application No. 49780
Permit No. 37260

R4W

RECEIVED

STATE ENGINEER
SALEM, OREGON

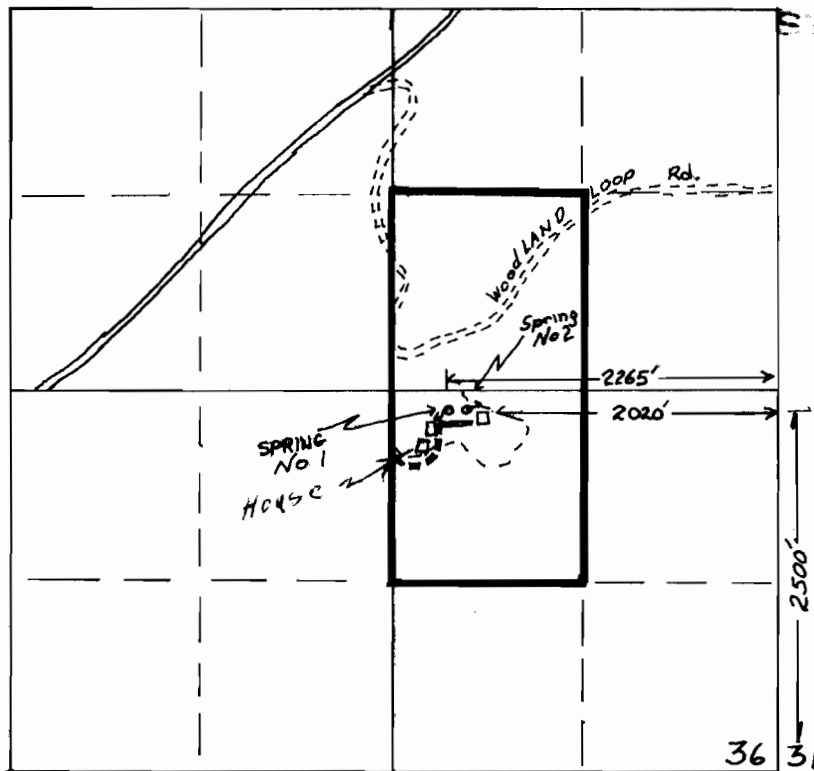

WATER RIGHT APPLICATION
LOCATION MAP

Name H. S. Myers
Sec 36 Twp 2S Rge 4W W.M.
TRACING DFQ-300-173
Scale 1" = 1320'