


# TOWNSHIP 5N. RANGE 27E. W.M.

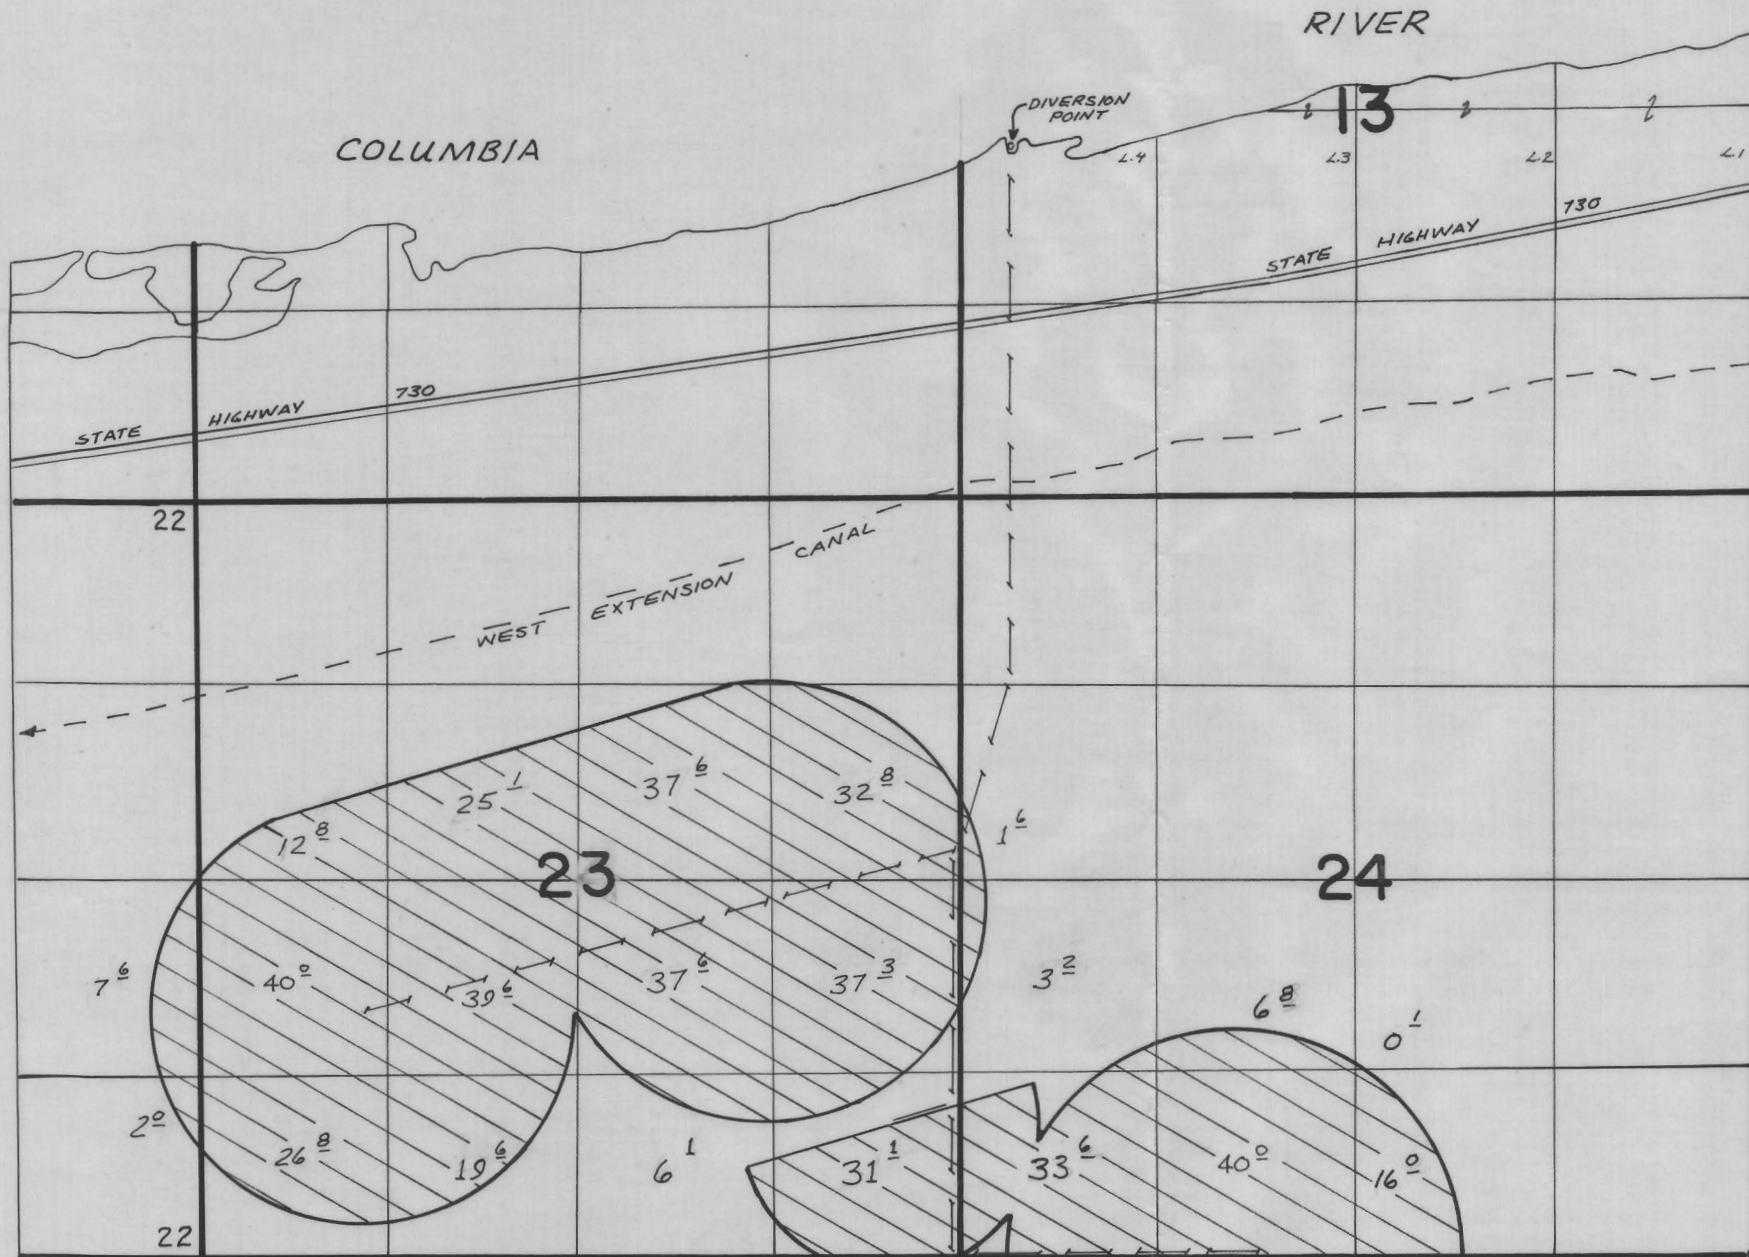

DIVERSION POINT LOCATED 2300' N. & 350' E.  
FROM SW COR SEC 13

B.C.  
SE COR SEC 24

## FINAL PROOF SURVEY

UNDER

APPL. 51262 PER. 37275

OREGON POTATO, INC.

SURVEYED MAY 3, 1978 BY R. BARWIN