


**RECEIVED**

FEB 20 1973

STATE ENGINEER  
SALEM, OREGON

T. 4 S. R. 3 W. W. M.

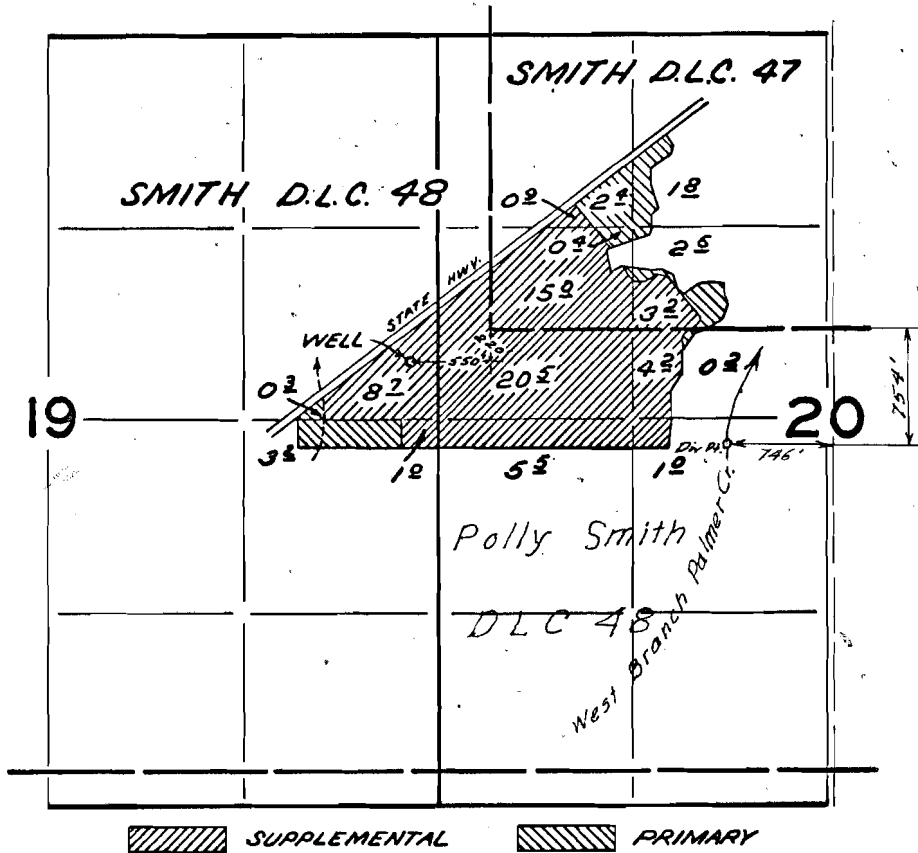

**FINAL PROOF SURVEY**  
UNDER

Application No. G-3344 Permit No. G-3140

IN NAME OF

SAMUEL B. SWEENEY

Surveyed JUN. 2, 1967, by V. GARNER

Application No. 50058  
Permit No. 37376