


TWP 1 S R. 35E. Union County.

COUNTY

RECEIVED
JUL 1 1973
STATE ENGINEER
SALEM OREGON

RECEIVED
SEP 13 1973
STATE ENGINEER
SALEM, OREGON

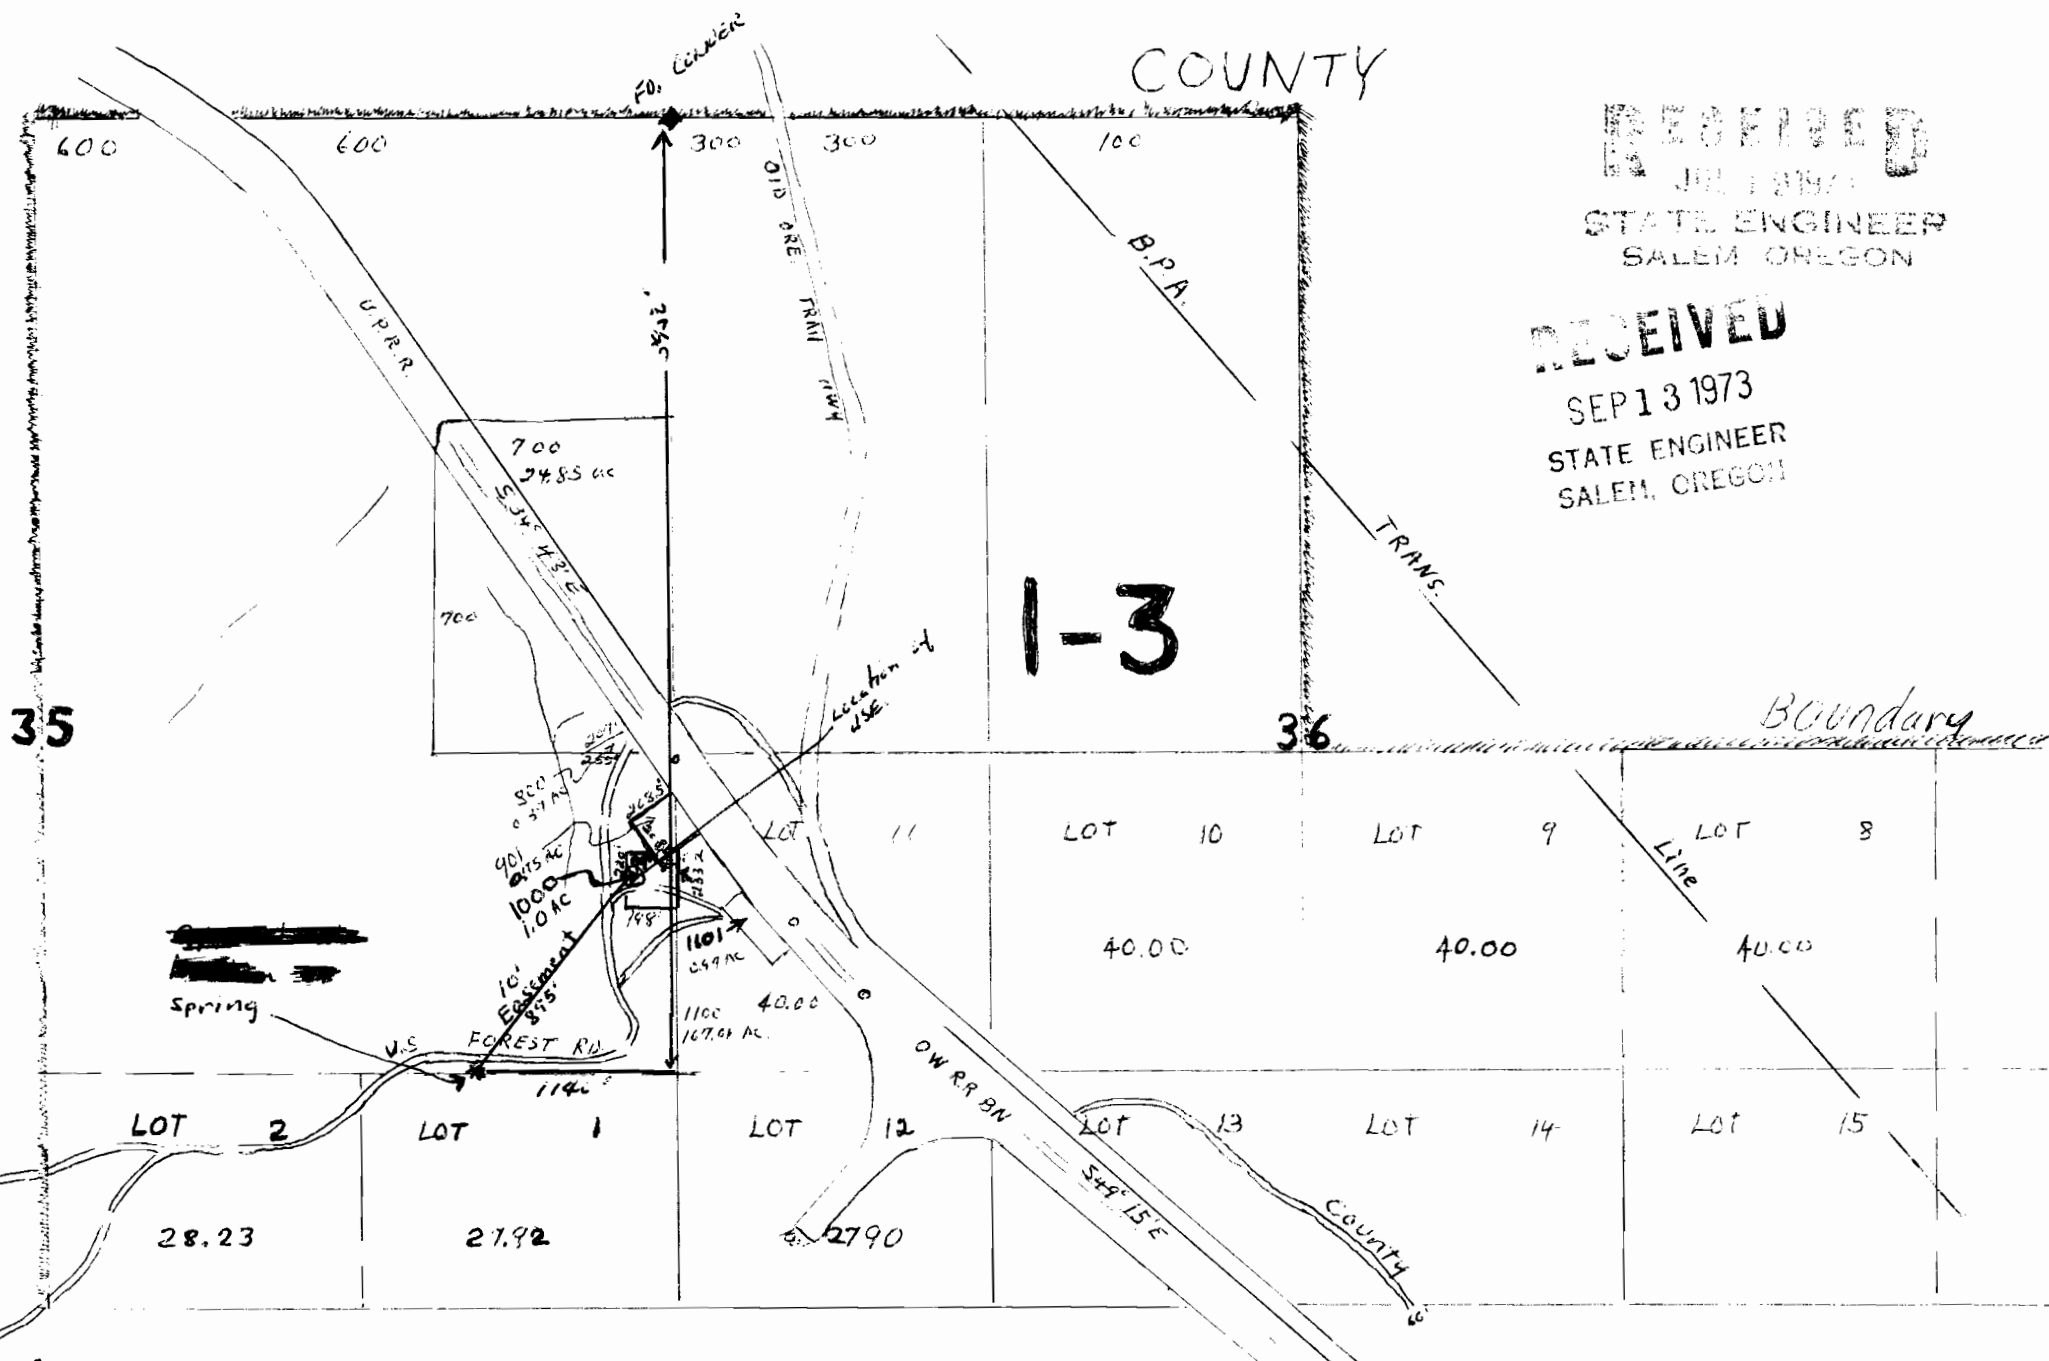

Application No. 50894
Permit No. 37387

Scale: 1" = 800'