


Little N. Fork
Santiam River

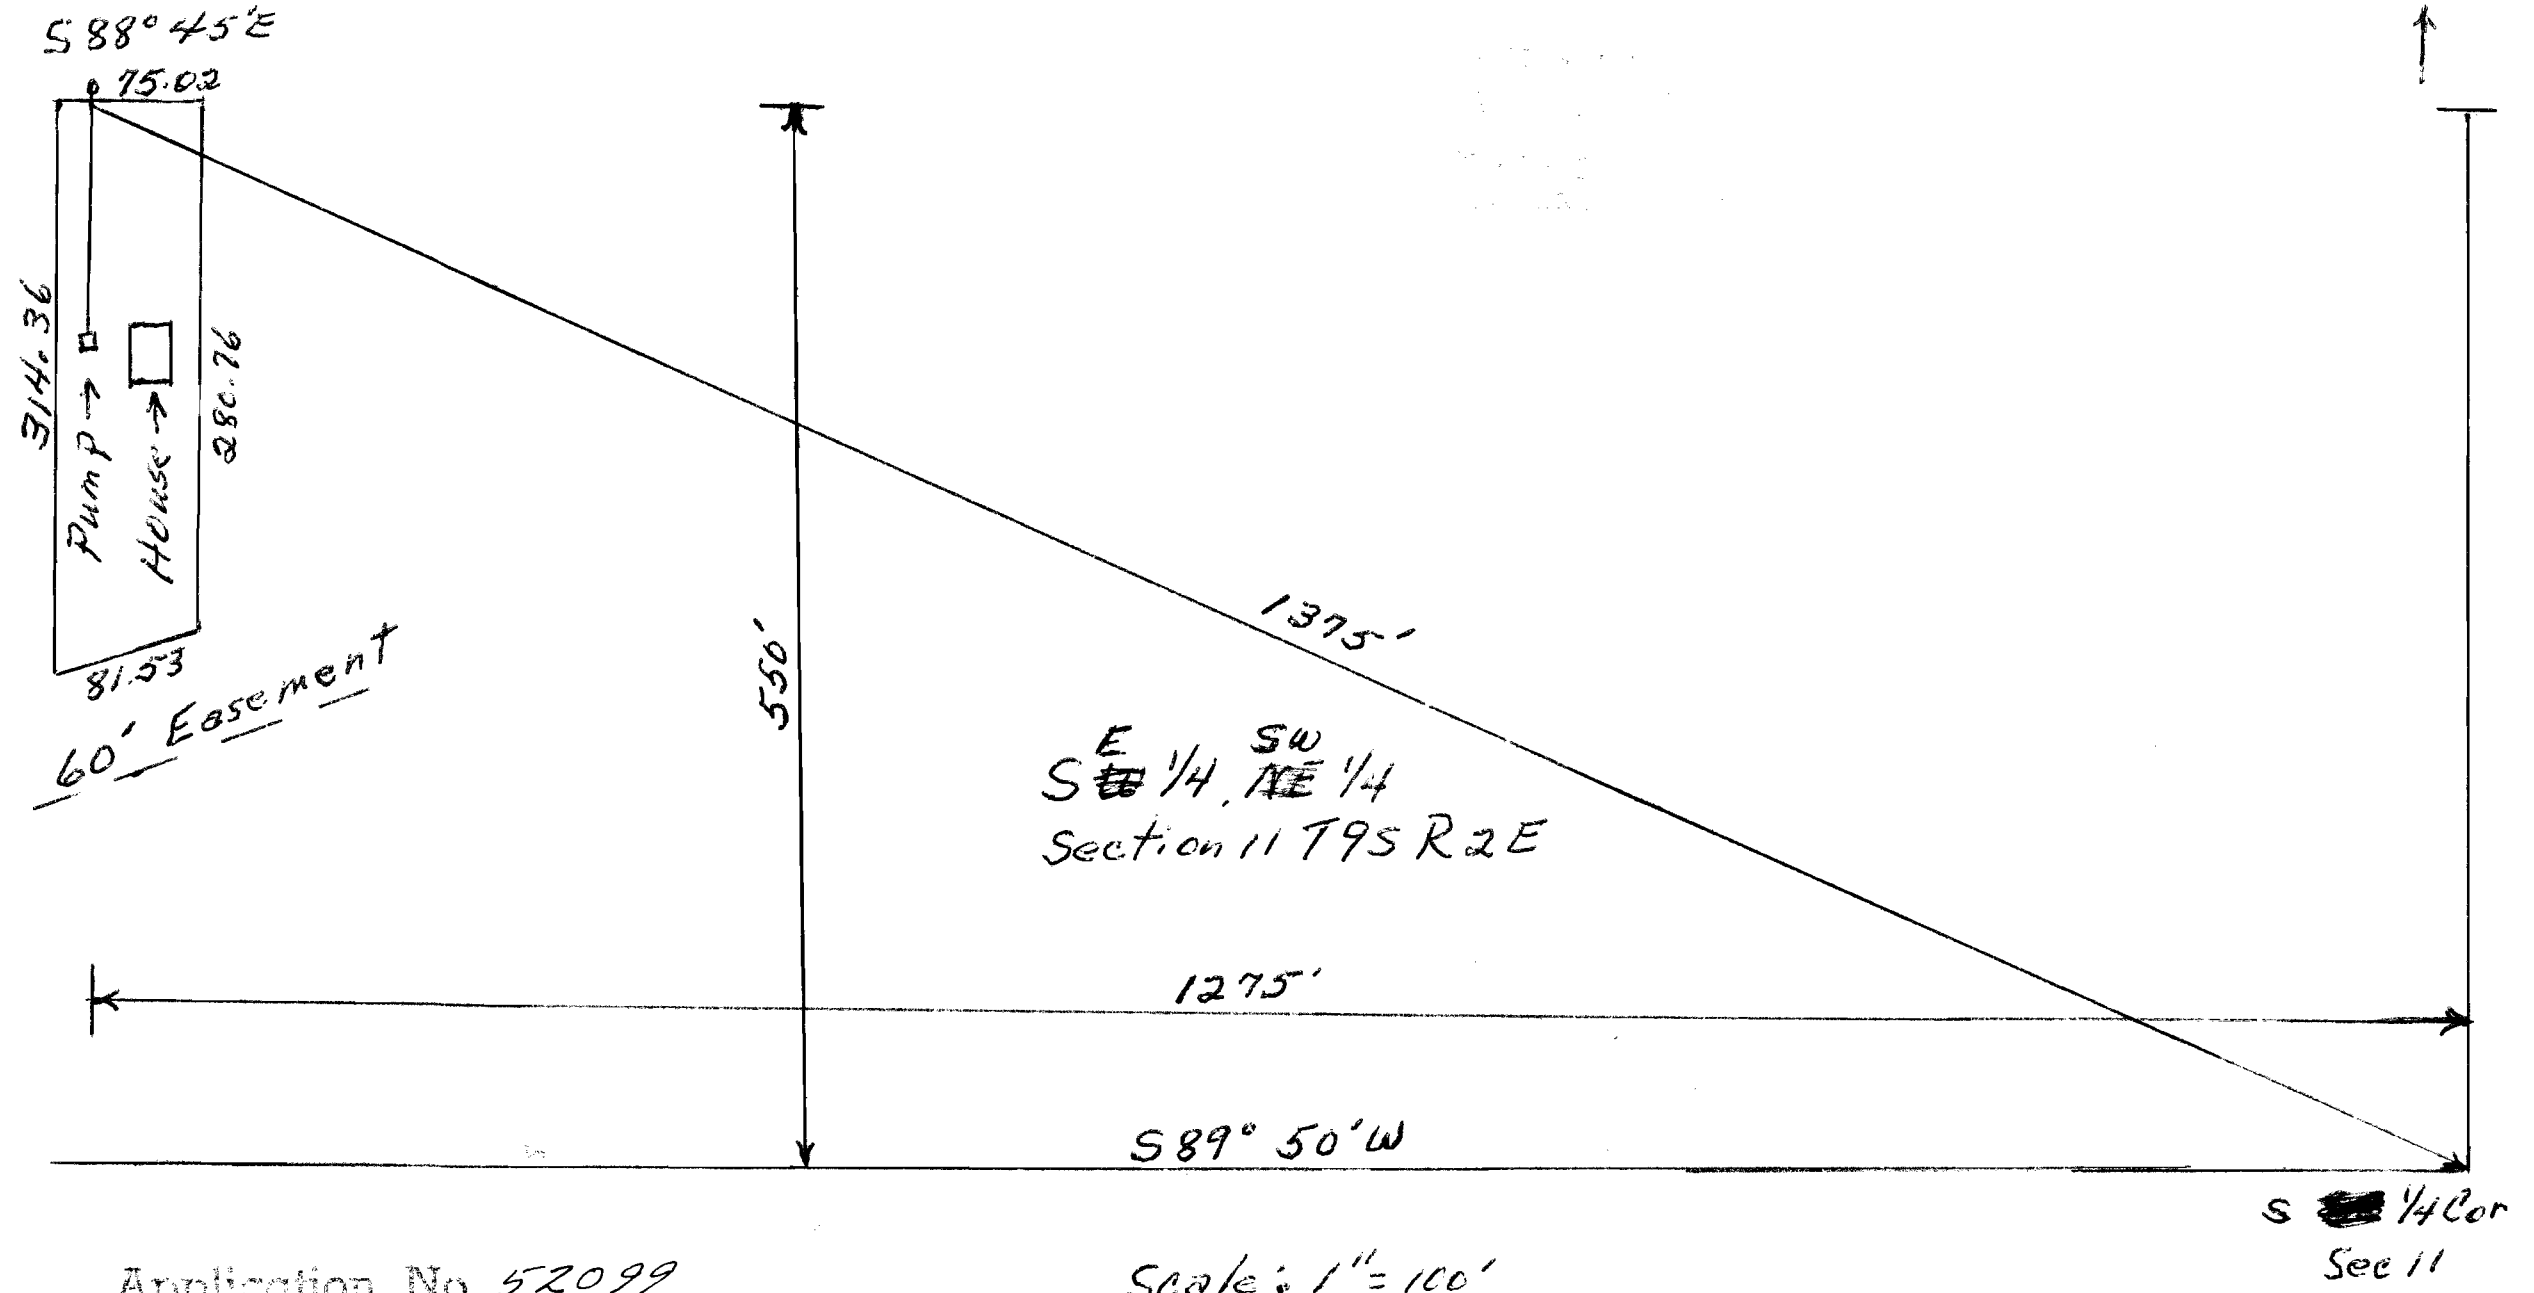

Application No. 52099
Permit No. 37444

Scale: 1" = 100'

S 1/4 Cor
Sec 11