


T. 13 S. R. 10 W. W.M. :

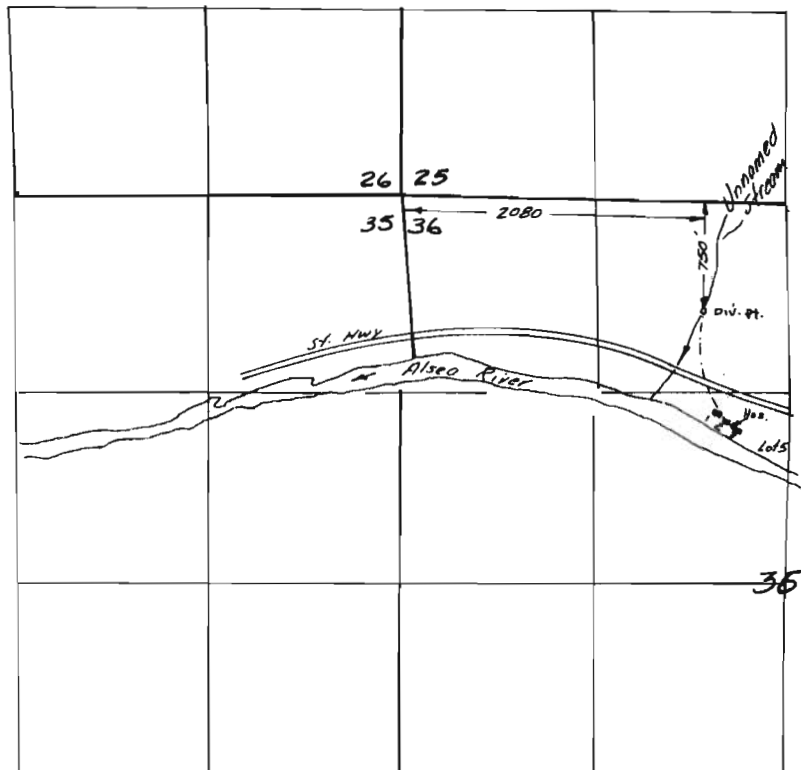

1. Williams
2. Hawkins
3. Murry

Application No. 52038

Permit No. 37523