


RECEIVED
JAN 24 1973
STATE ENGINEER
SALEM, OREGON

RECEIVED
SEP 26 2003
WATER RESOURCES DEPT
SALEM, OREGON

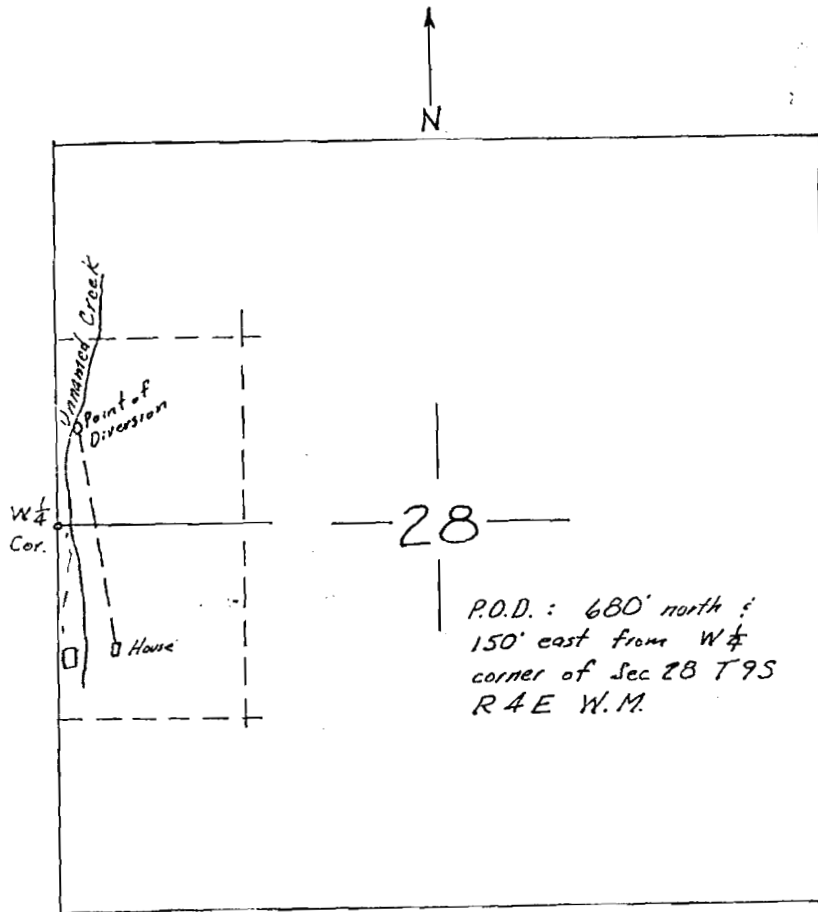

T9S R4E W.M.
Scale: 4" = 1 mile

Map for application 49999

Approved by Henry Hebert

Application No. 49999
Permit No. 37600