


T. 38 S., R. 6 W., W.M.

SEC. 2

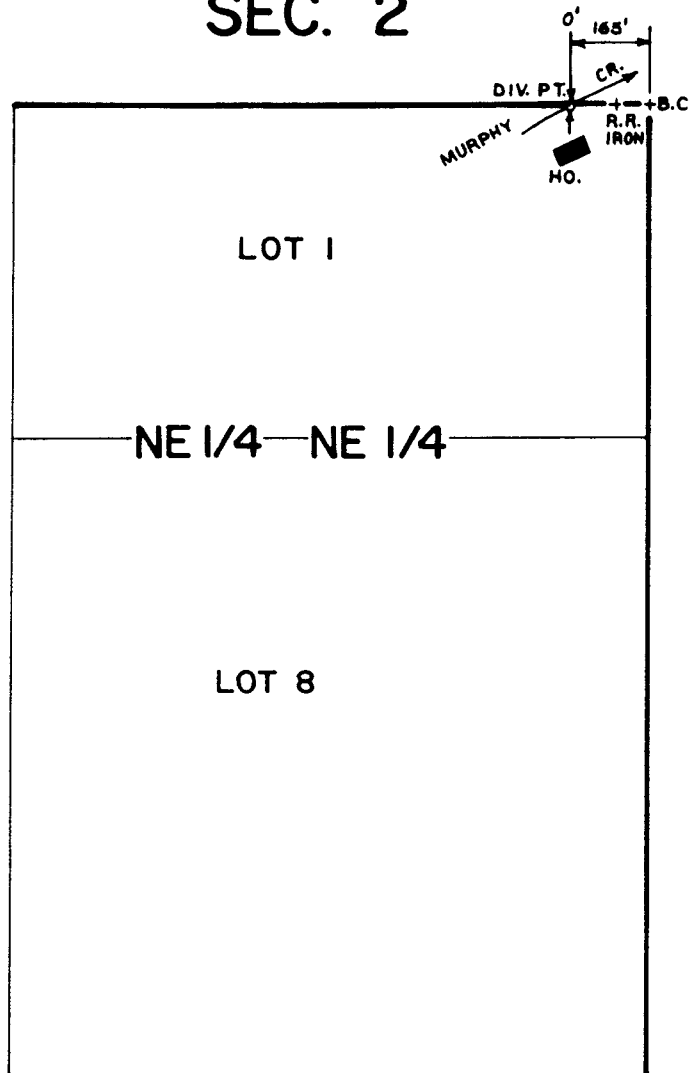

MAY 23 1989

SCALE: 1" = 400'

**FINAL PROOF SURVEY**  
UNDER

Application No. 50071 Permit No. 37629  
IN NAME OF  
DONALD & ANN KOVACH  
Surveyed JUNE 17, 1982, by BRUCE R. SUND

PTS-1982-14A TWB