


T. 33 S., R. 6 W., W. M.

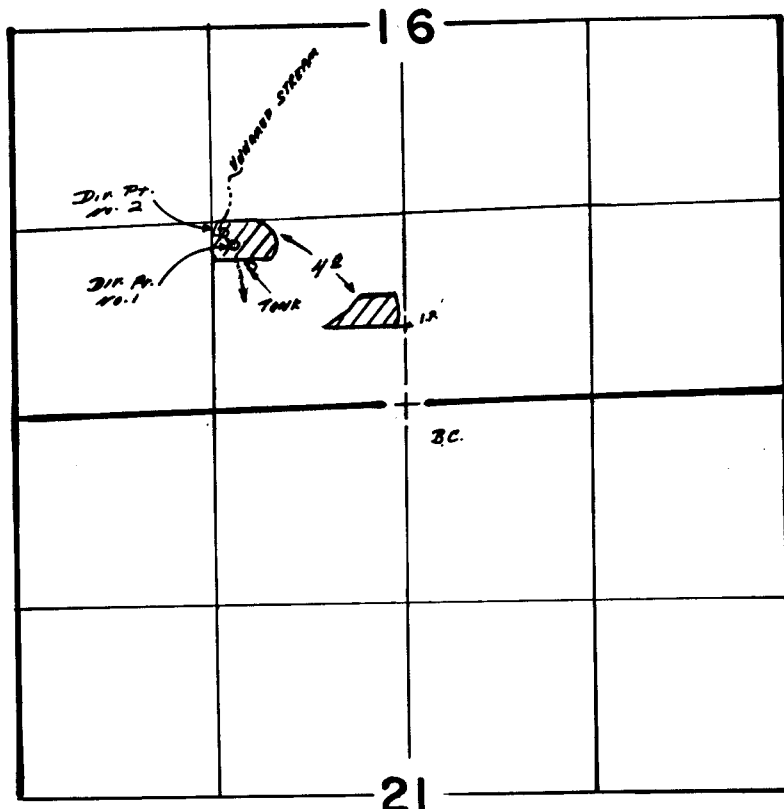

RECORDED  
MAR 16 1988  
WM. DIST. CL.  
GRANTS PASS, ORE.

*DIVERSION No. 1: 1150' N., 1190' W.; No. 2: 1200' N., 1250' W.;  
Both FROM S/4 COR. SEC. 16*

Scale: 1" = 1320'

**FINAL PROOF SURVEY**  
UNDER

Application No. 50097. Permit No. 37642.  
IN NAME OF

DR. W. D. & CORALEE NAYLOR

Surveyed APR. 30. 1986, by B. S. JAMES.