


# T. 36 S., R. 7 W., W.M.

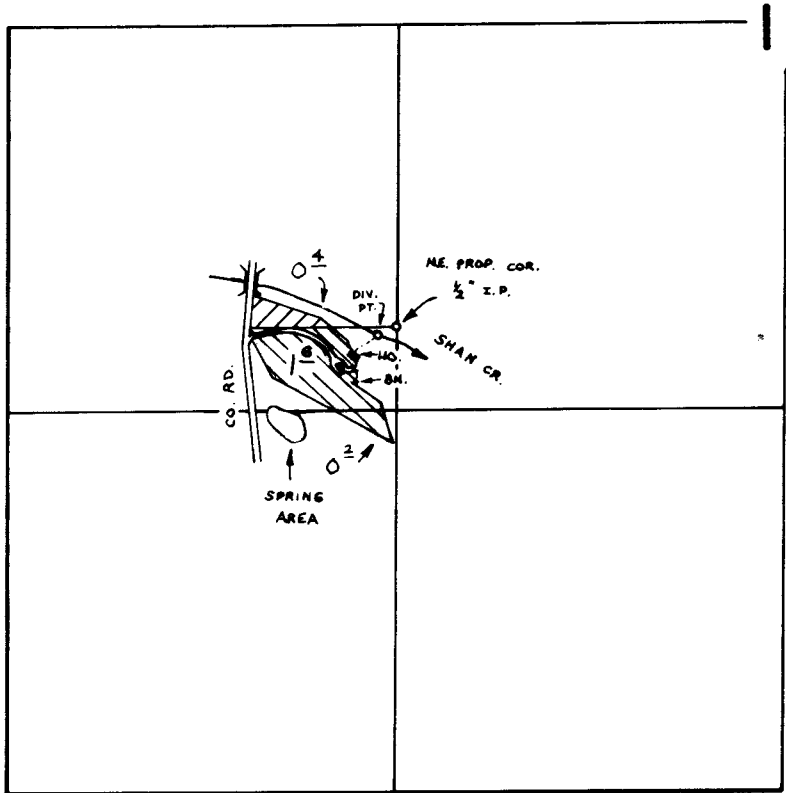

DIV. PT. LOC.: 1060'S. & 1250'E., SPRING LOC. - 1350'S. & 950'E.,  
 BOTH FROM W. 1/4 COR., SEC. 11.

SCALE: 1" = 660 FT.

## FINAL PROOF SURVEY

UNDER

51002 38496

50119 37661

Application No. 50704 Permit No. 38297

IN NAME OF

DANIEL LARRY JACKSON

Surveyed NOV. 14 1977, by B. SUND

RECEIVED

OCT 21 1981

WM. DIST. 14  
 GRANTS PASS, ORE.



D.H.M.

P.T.S. - 1977 - 14 - B