


# T. 35 S., R. 7 W., W.M.

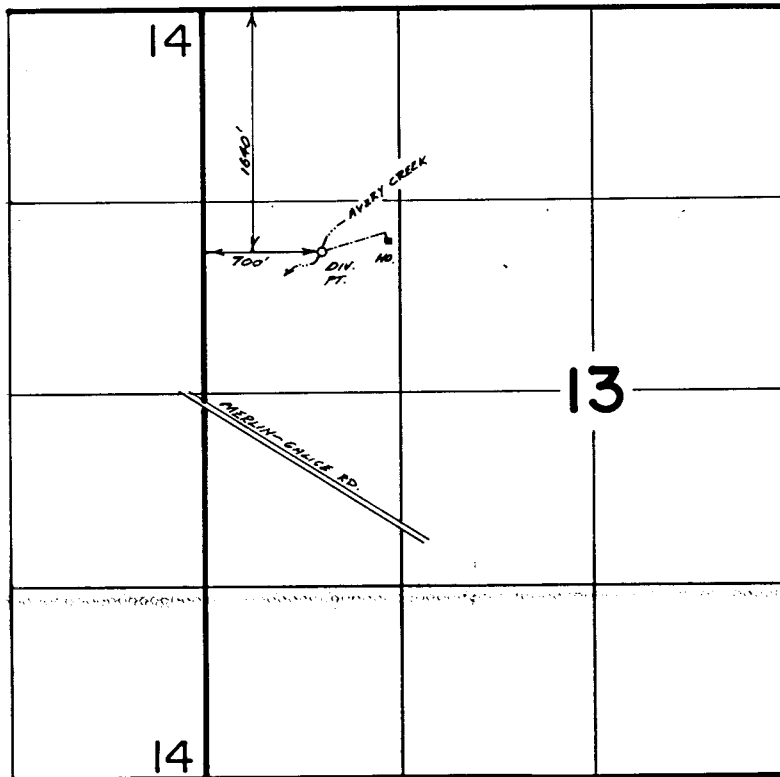

Scale 1"=1320'



RECEIVED  
 OCT 31 1987

## FINAL PROOF SURVEY UNDER

Application No. 50138.. Permit No. 37671.....  
 IN NAME OF

...RONALD... JAMES... THOMPSON...

Surveyed Oct. 26., 1987., by B.S. JAMES.....