
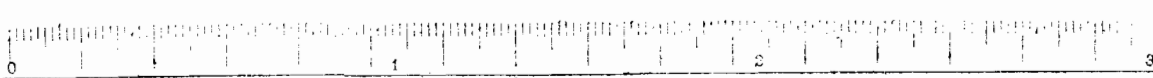


Township 12 South, Range 6 West W.M.

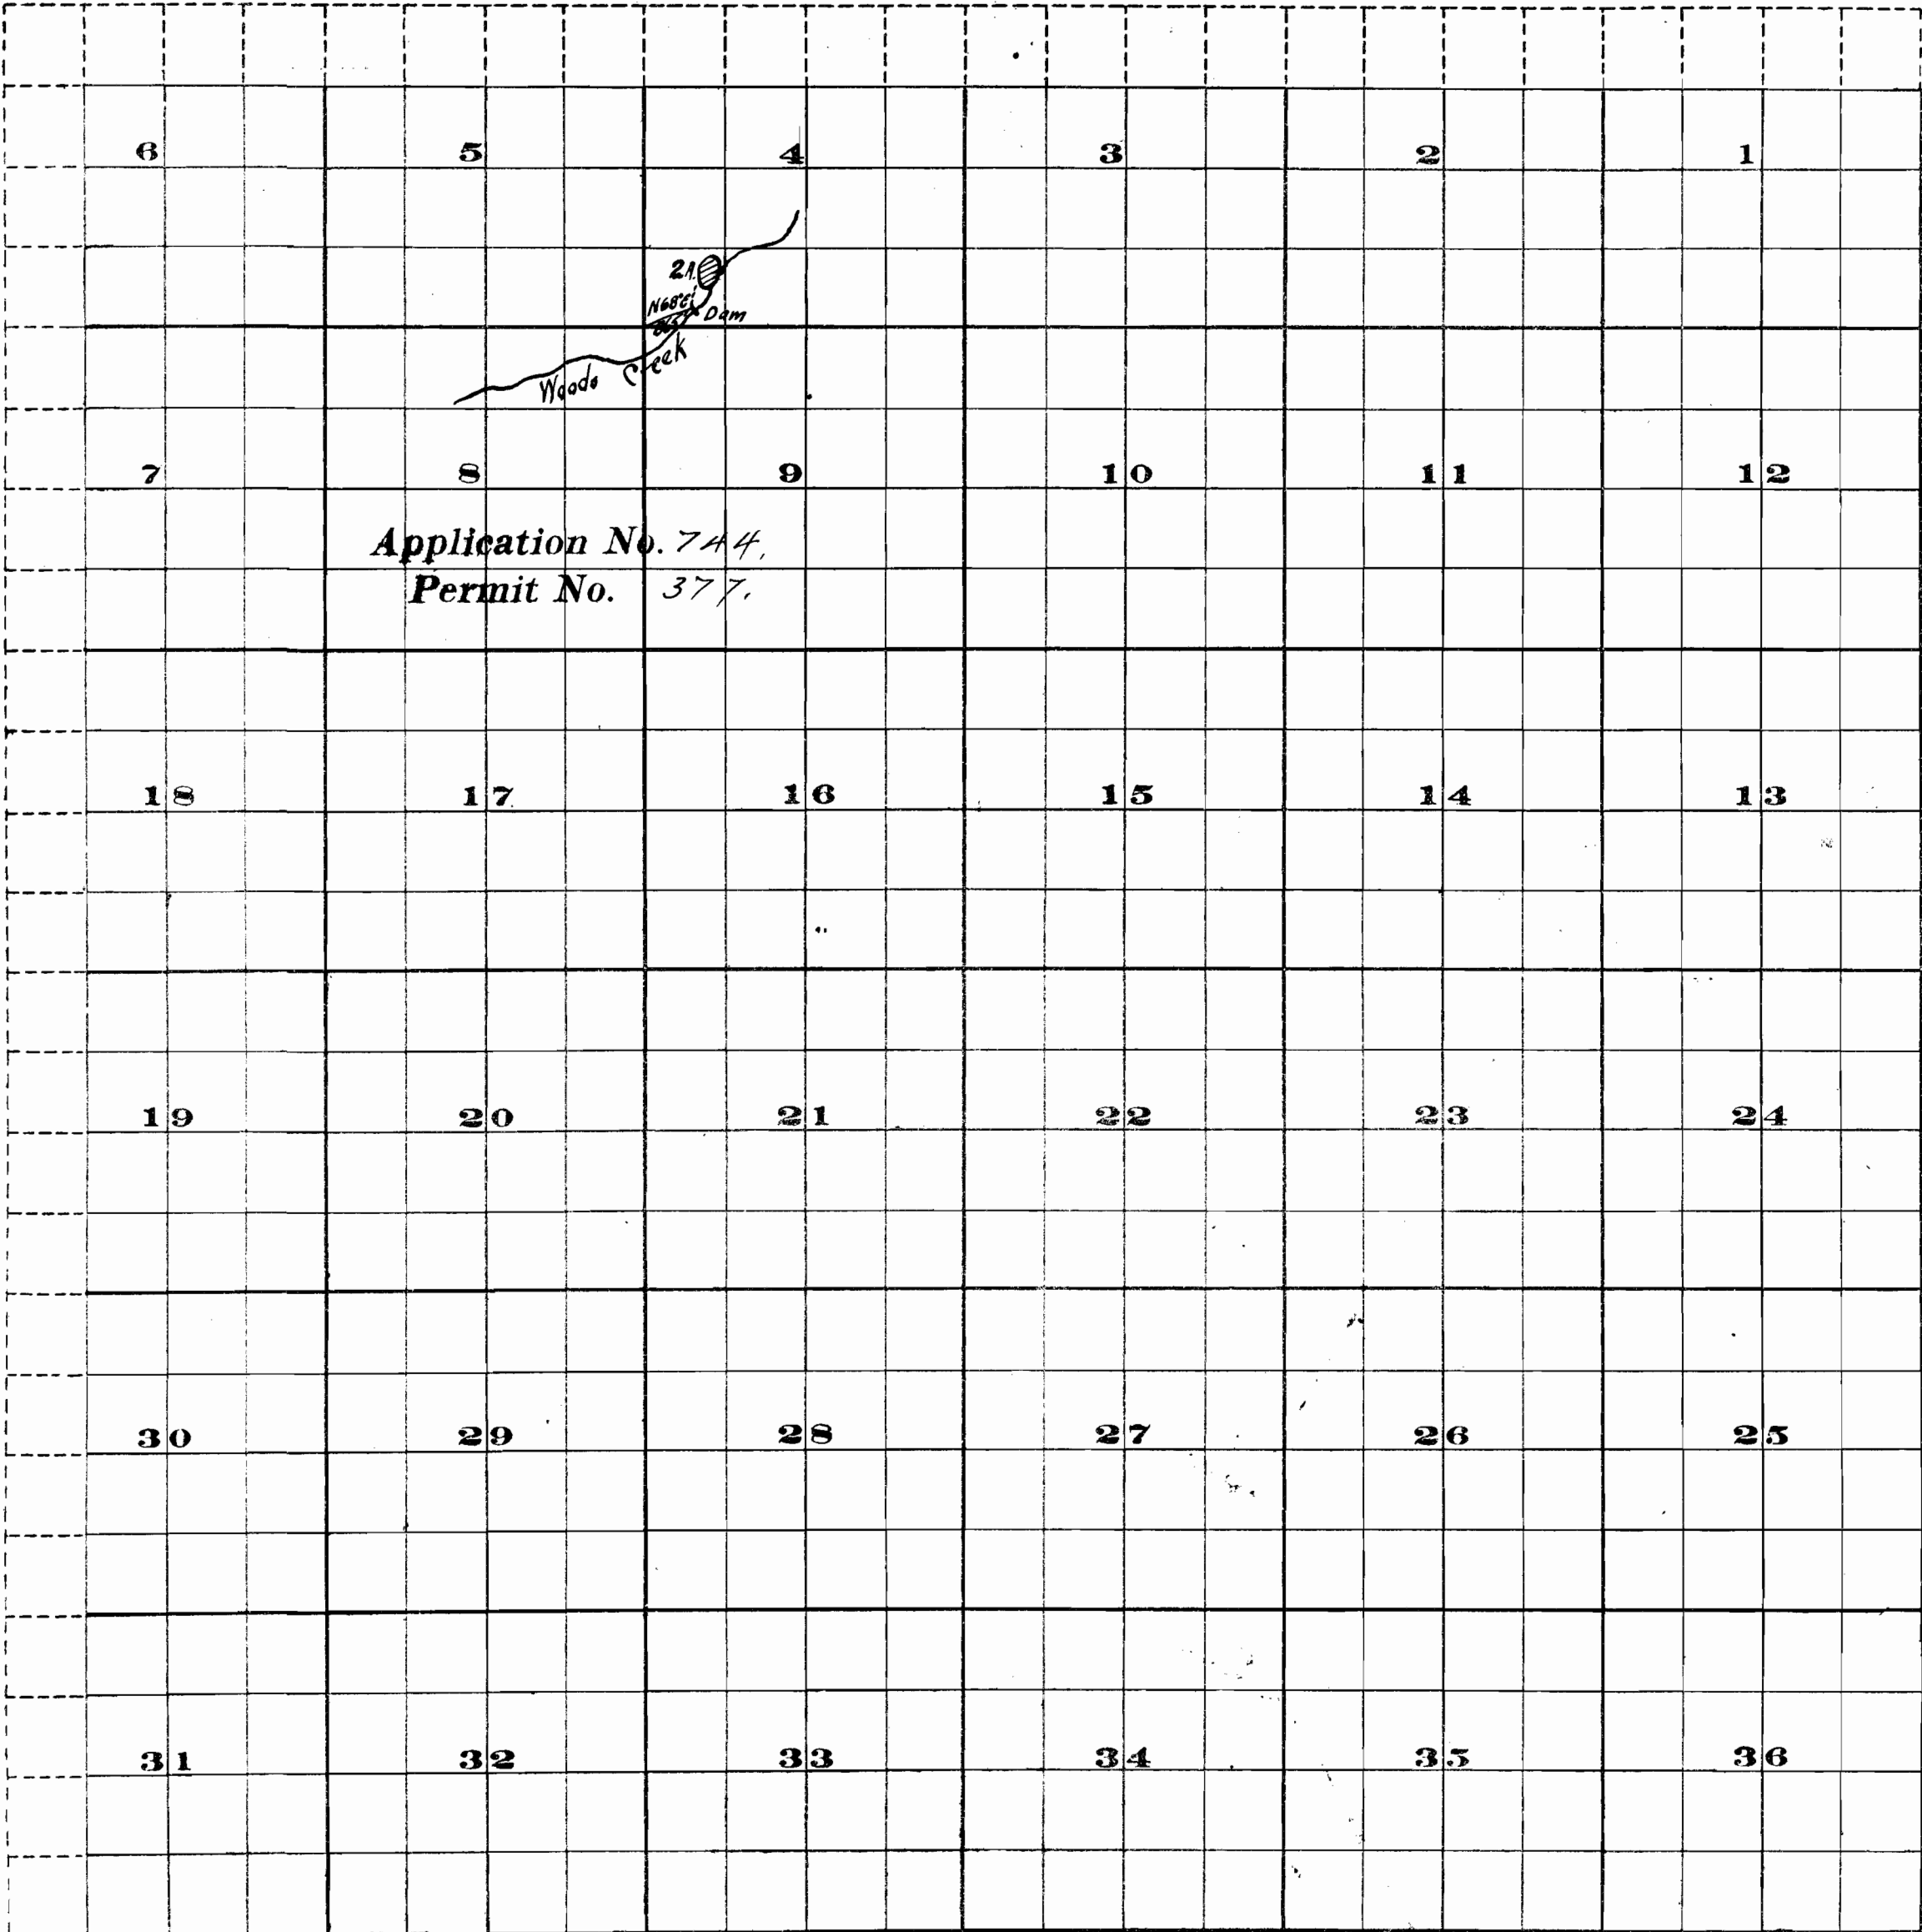

Scale of Feet.

FROM OFFICE OF THE STATE ENGINEER, SALEM, OREGON

These notes were taken during an actual survey. Sept. 18th 1909.

by Chas. L. Swain
Surveyor.