


T. 36 S., R. 7 W., W.M.

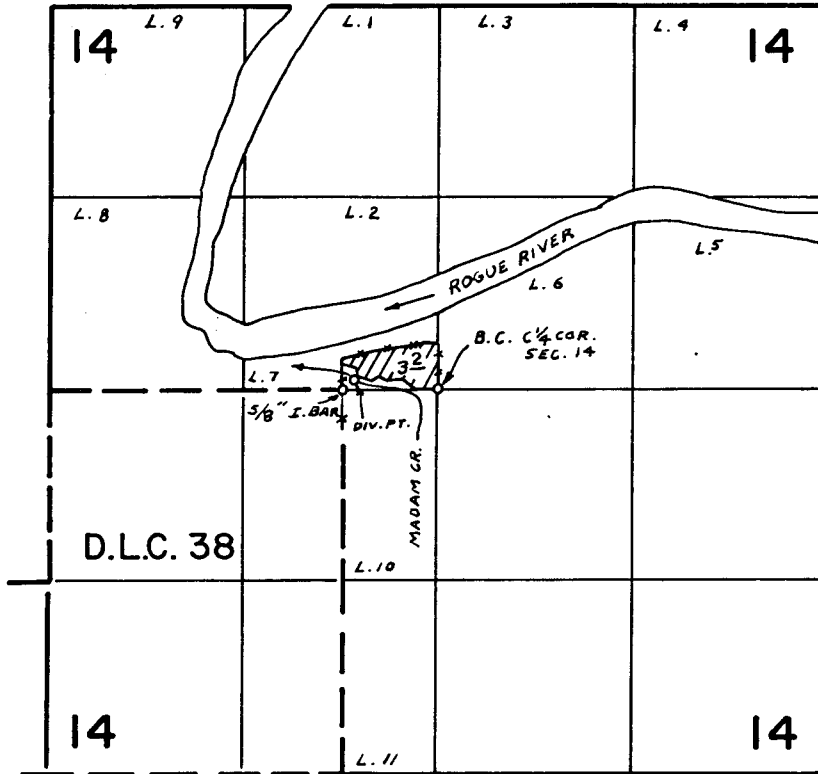

DIV. PT. LOC.: 60' N. & 70' E. FROM NE COR. D.L.C. 38

RECEIVED  
MAY 19 1980  
WM. DIST. 14  
GRANTS PASS, ORE.

FINAL PROOF SURVEY  
UNDER

Application No. 50800 Permit No. 37760  
IN NAME OF

LLOYD O. GUINN

Surveyed NOV. 9 1977 by B. SUND

P.T.S. - 1977-14-B