


T. 9 S. R. 3 E. W. M.

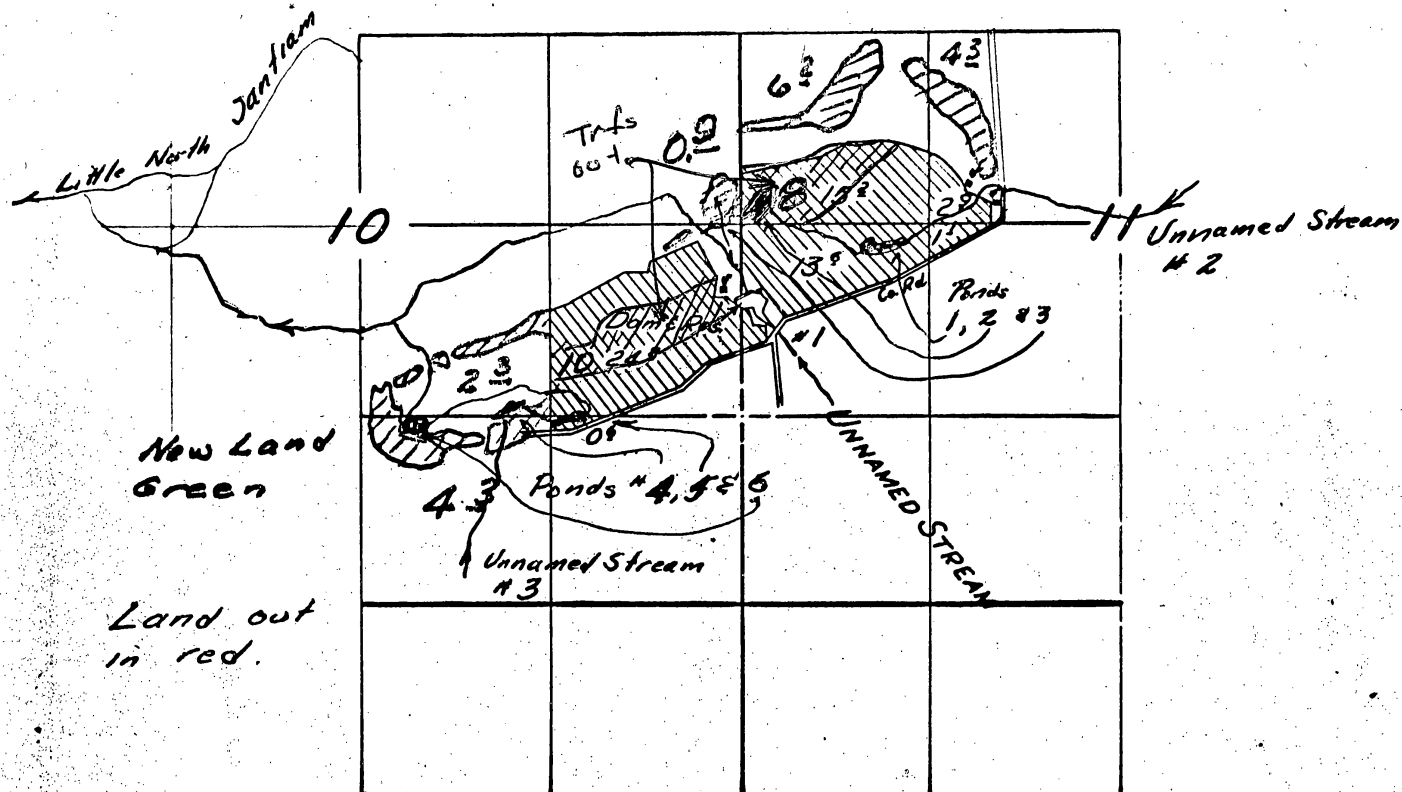

FINAL PROOF SURVEY

UNDER

R-20549

R-1393

Application No. 20550

Permit No. 21578

IN NAME OF

BILL BICKETT

Surveyed 23 July 1956, by

Application No.

R-52804 & 52805

Permit No.

R 6116 & 37778