
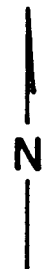


T.37S., R.9W., W.M.

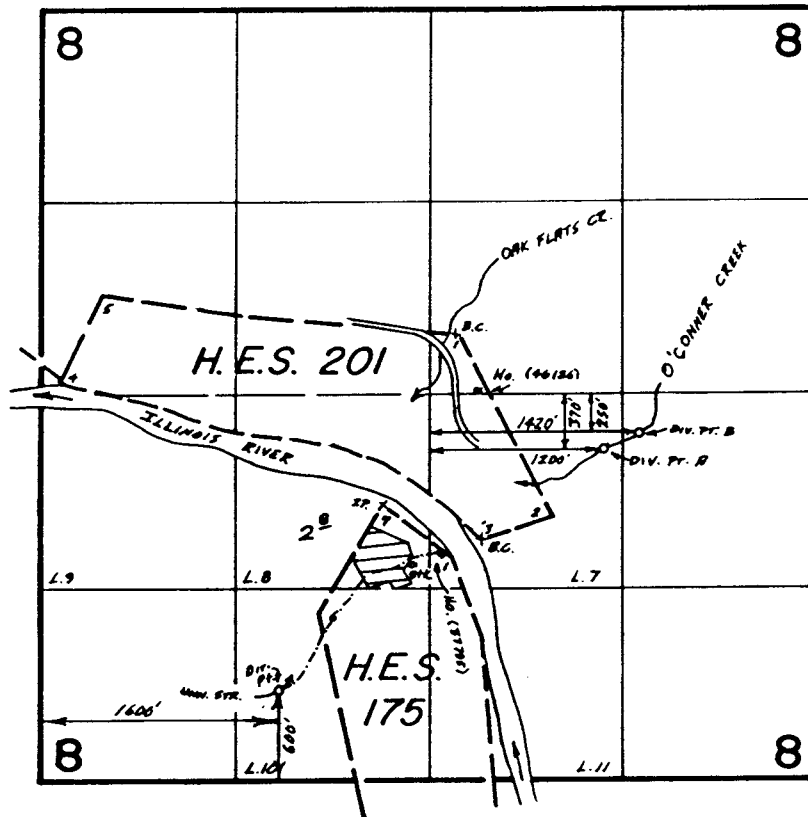

RECEIVED

JUL 20 1989

REC'D DIST. 14
GREENSBURG, ORE.

Scale 1"=1320'

FINAL PROOF SURVEY
UNDER

52266 37795
Application No. 61274 Permit No. 46126
IN NAME OF

DOLORIS M. LLOYD

Surveyed Aug. 10, 1984, by B.S. JAMES