


RECEIVED  
STATE ENGINEER  
SALEM, OREGON

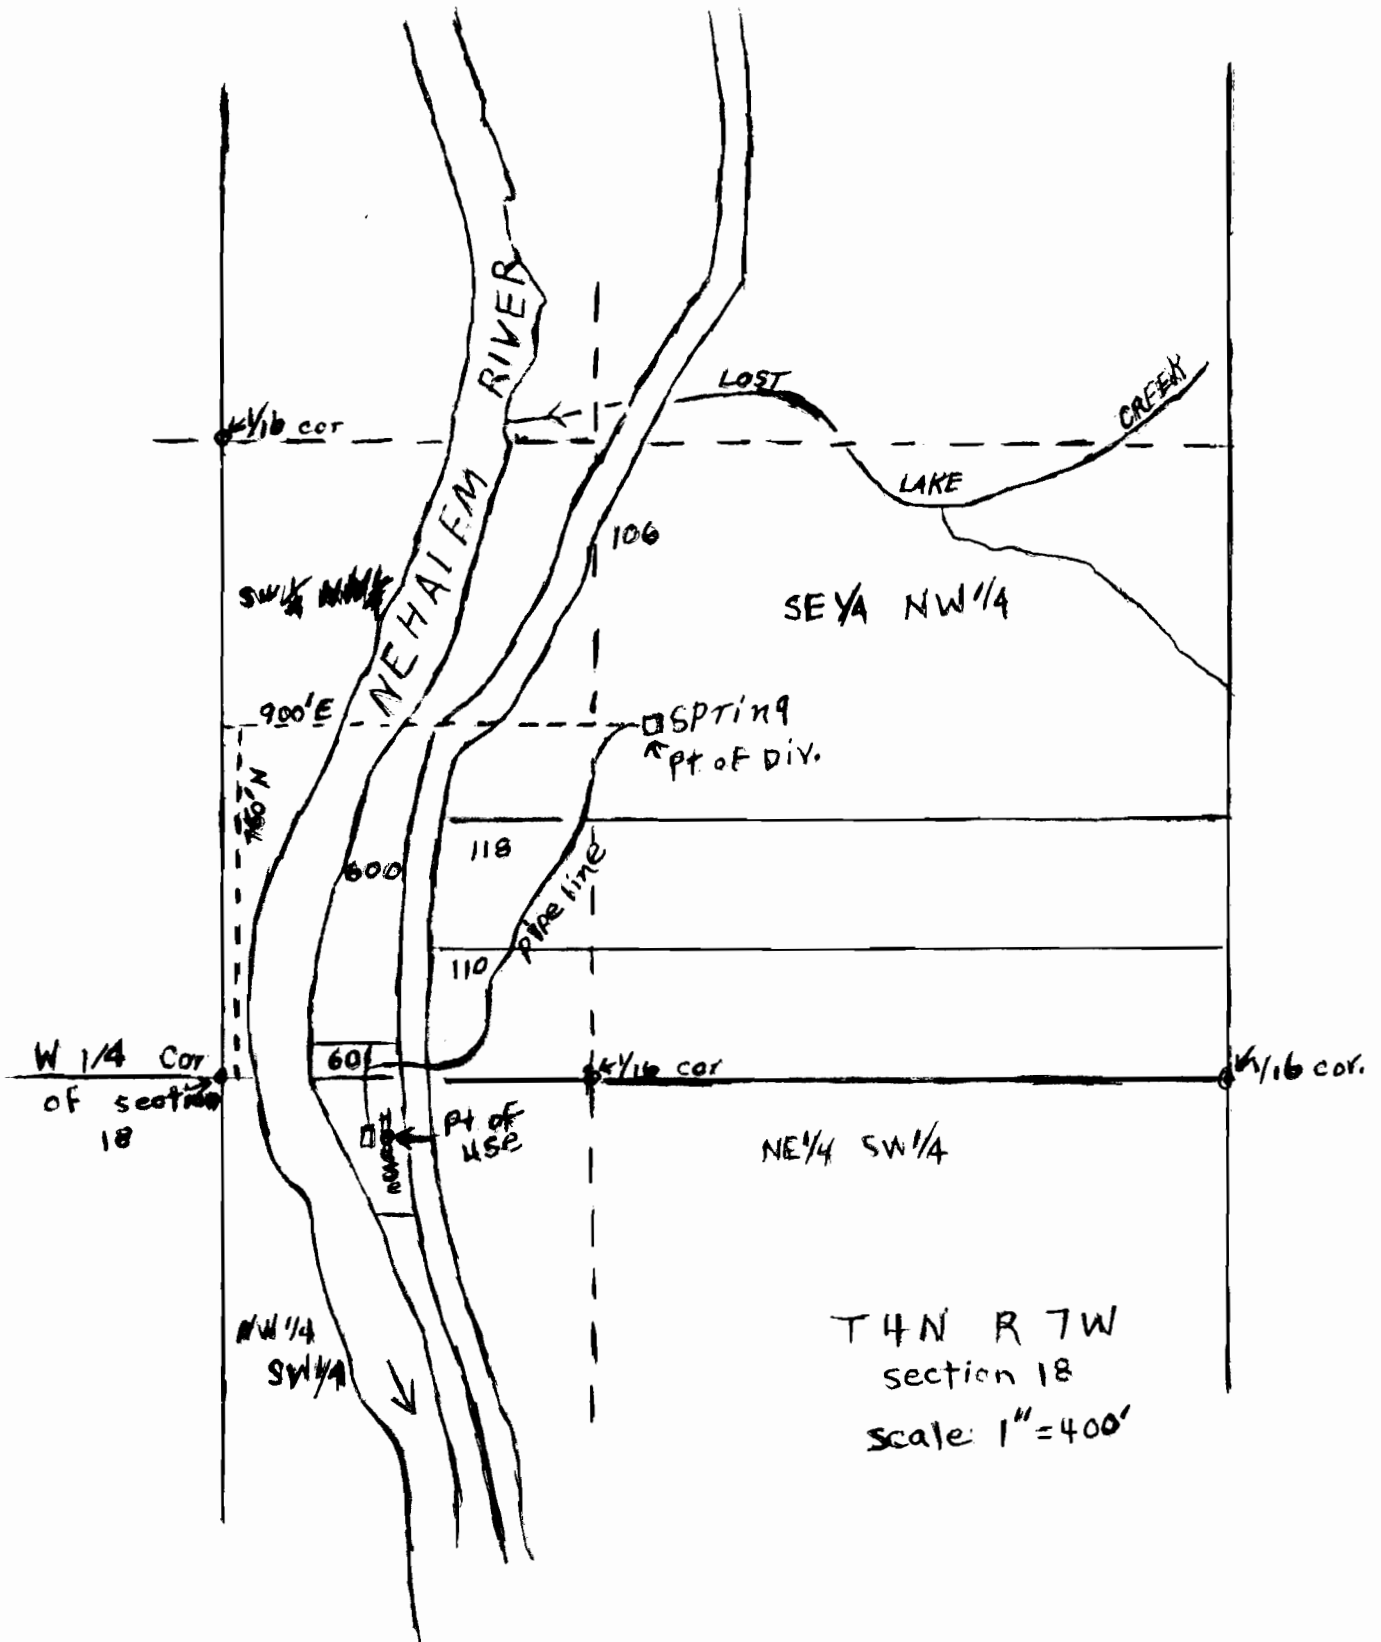

Application No. 49837  
Permit No. 37871