


T.38 S., R.8 W., W.M.

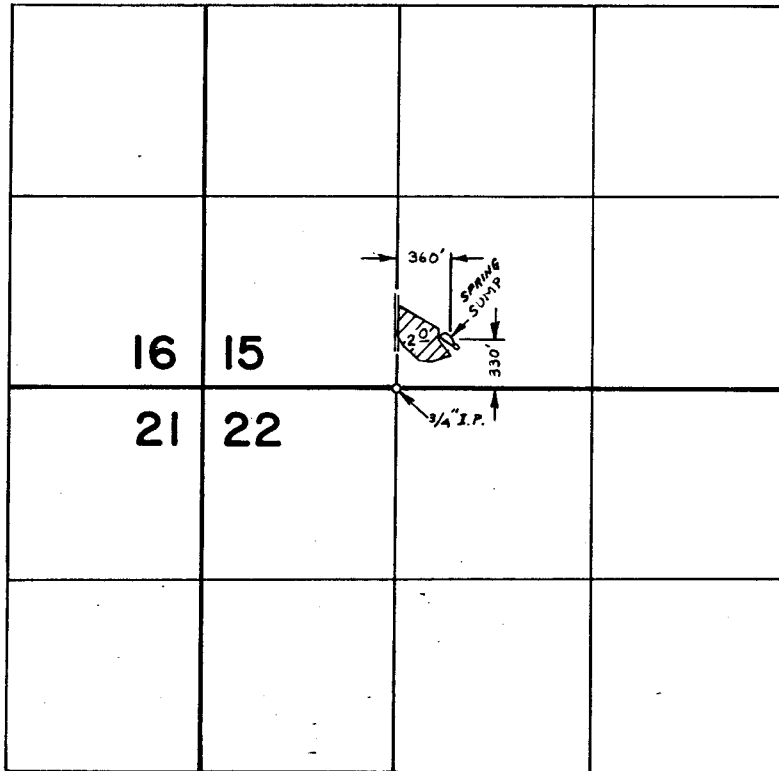

RECEIVED  
 OCT 1 1981  
 WM. DIST. 14  
 GRANTS PASS, ORE

**FINAL PROOF SURVEY**  
 UNDER

Application No. 50079 Permit No. 37906 SUPPL.  
 IN NAME OF

VINCENT D. BEAN

Surveyed OCT. 27 1978, by B. SUND

P.T.S. - 1978 - 14 - D