


Permit: S 37907  
Volume: 1  
Strm: ROGUE R  
Trib: PACIFIC OCEAN  
Priority: 3/30/73

T. 36S., R. 5W., W.M.

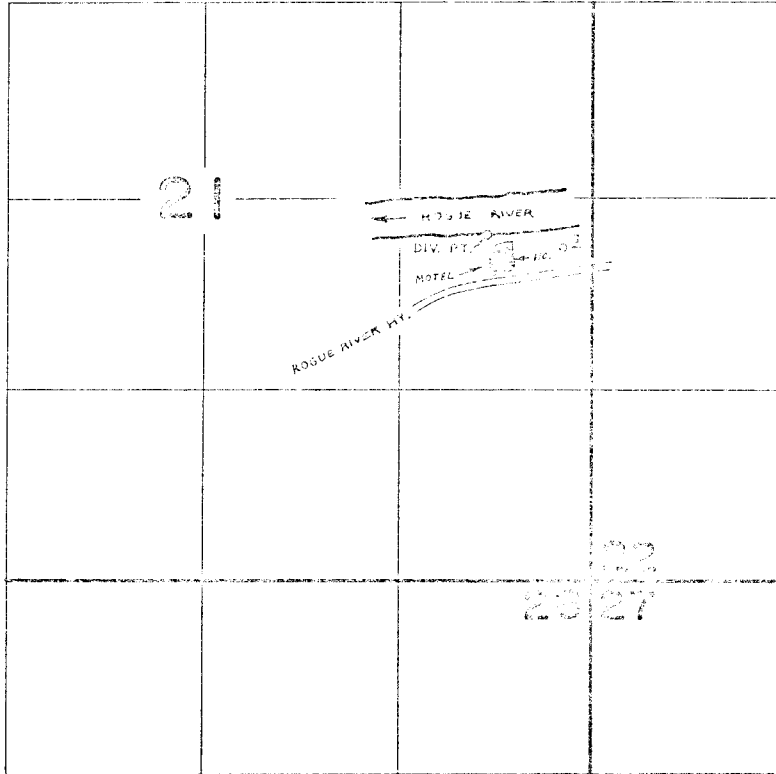

DIV. PT. LOC. 2380' N. & 4560' E. FROM SW COR. SEC. 21

UNITED STATES DEPARTMENT OF THE INTERIOR  
BUREAU OF LAND MANAGEMENT  
LAND

RECEIVED  
MAY 19 1980  
WM. DIST. 14  
GRANTS PASS, ORE.

Application No. 50232 Permit No. 37907  
Name of

RUSSEL G. NYE

Survey of OCT. 6, 1977, by B. SUND