

UNITED STATES DEPARTMENT OF AGRICULTURE
Soil Conservation Service
Oregon

RECEIVED
JUL 20 1973
STATE ENGINEER
SALEM, OREGON

LOCATION OF A.C.P. PRACTICES
Program Year _____

Operator MR. + MRS. RAYMOND S. BLACK

A.C.P. Farm No. _____


County DOUGLAS

Section 31 Township 20S

Range 9W

Aerial Photo No. BLM-CB-1-UMP 6-31

*X CORNER
STEEL PEG*

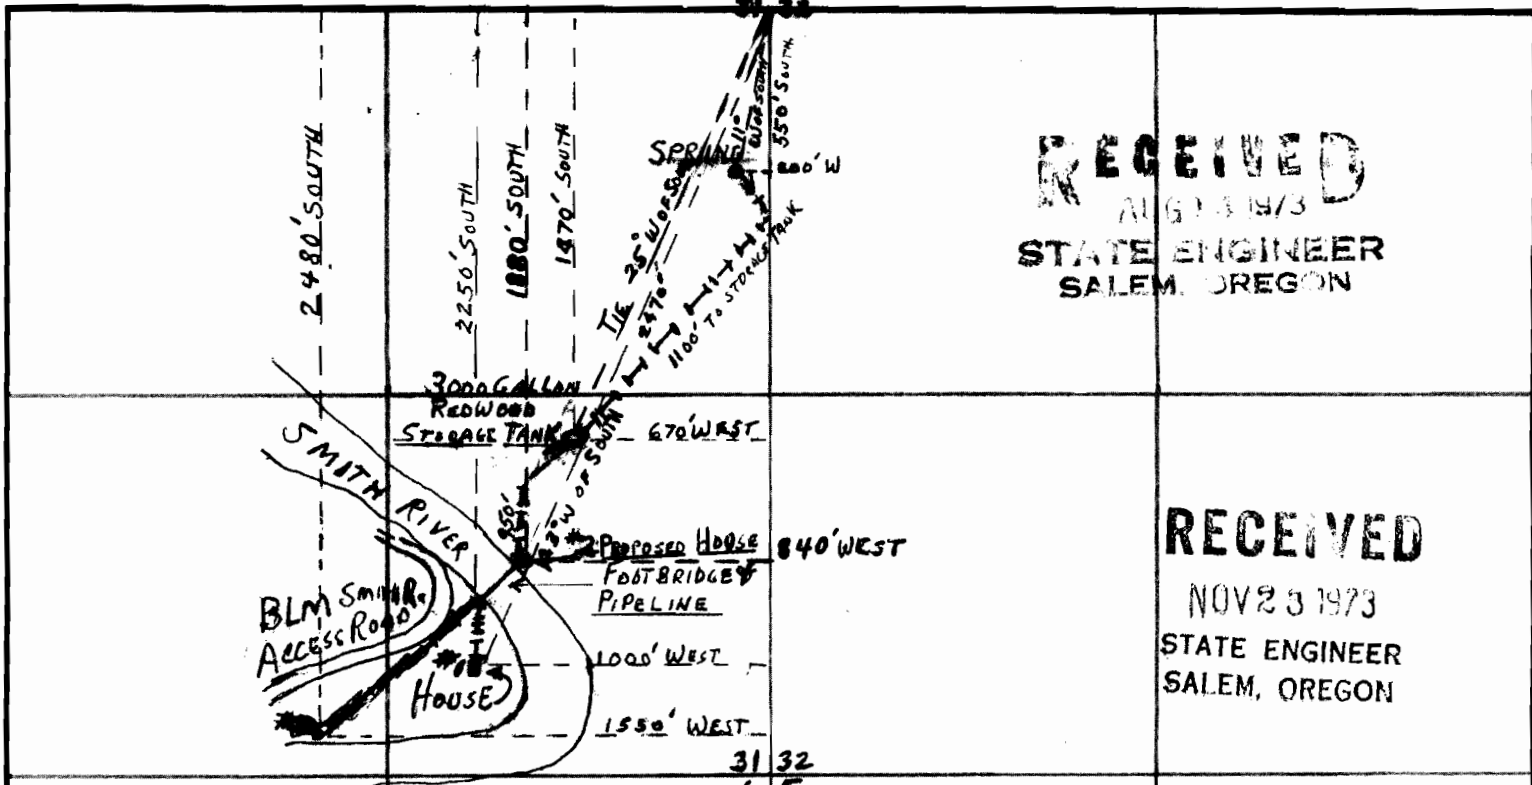

RECEIVED
AUG 13 1973
STATE ENGINEER
SALEM, OREGON

RECEIVED
NOV 23 1973
STATE ENGINEER
SALEM, OREGON

Application No. 50202
Permit No. 37912