

S.E. 1/4 SEC. 29


T.33 S. R.5 W.W.M.

Scale 1"=400'

RECEIVED

JUN 12 1975

STATE ENGINEER  
SALEM, OREGON

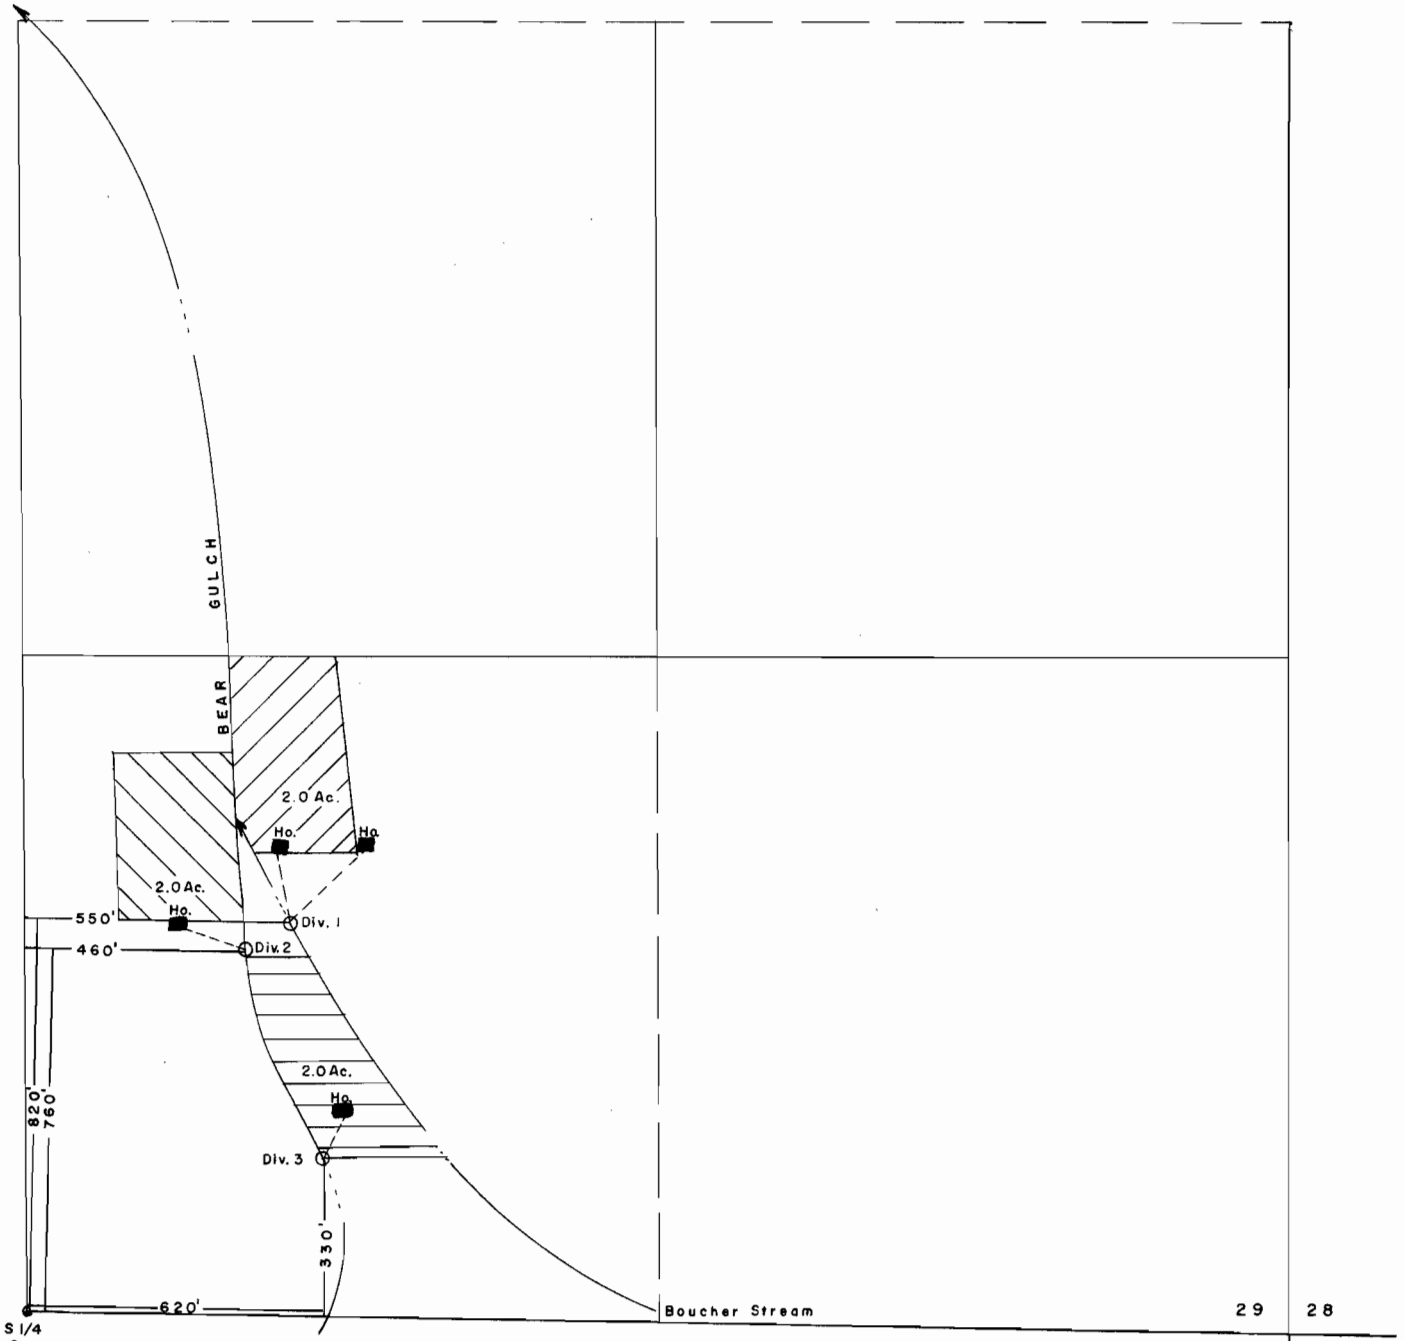

S 1/4  
Cor.

29 28

Application No. 50265

Permit No. 37961

32 33