

RECEIVED

OCT 3 0 1973


STATE ENGINEER
SALEM, OREGON



STATE ENGINEER

JUL 2 3 1973

STATE ENGINEER
SALEM, OREGON

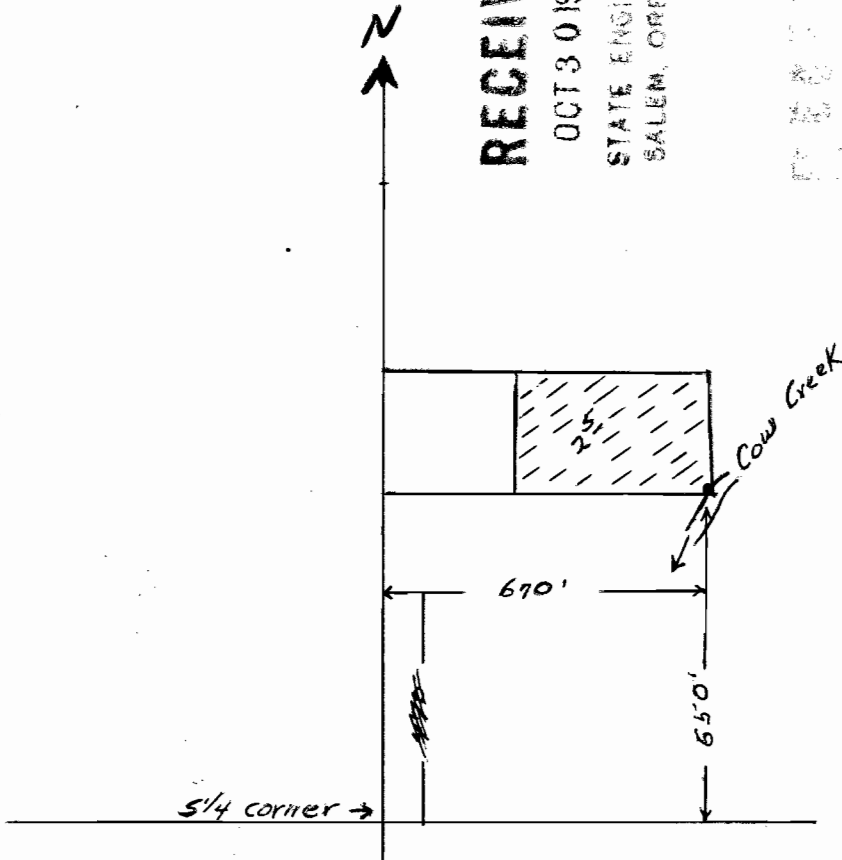

T325 R6W section 33
1"=400'

Application No. 50333
Permit No. 37998