


T.35S.,R.7W.,W.M.

RECEIVED

OCT 8 1980

WM. DIST. 14  
GRANTS PASS, ORE

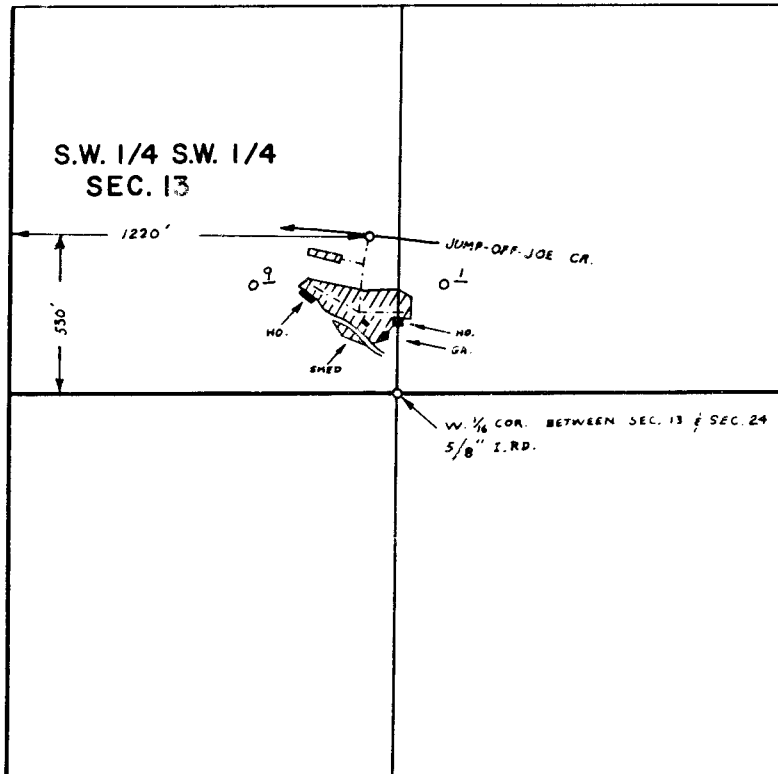

SCALE: 1" = 660 FT.

**FINAL PROOF SURVEY**  
UNDER

*Dist - 49542*

Application No. 50413 Permit No. 38046  
IN NAME OF

WILLA B. WARREN

Surveyed NOV. 18 1977, by B. SUND

P.T.S. - 1977-14 - B