


# T. 38 S., R. 8 W., W.M.

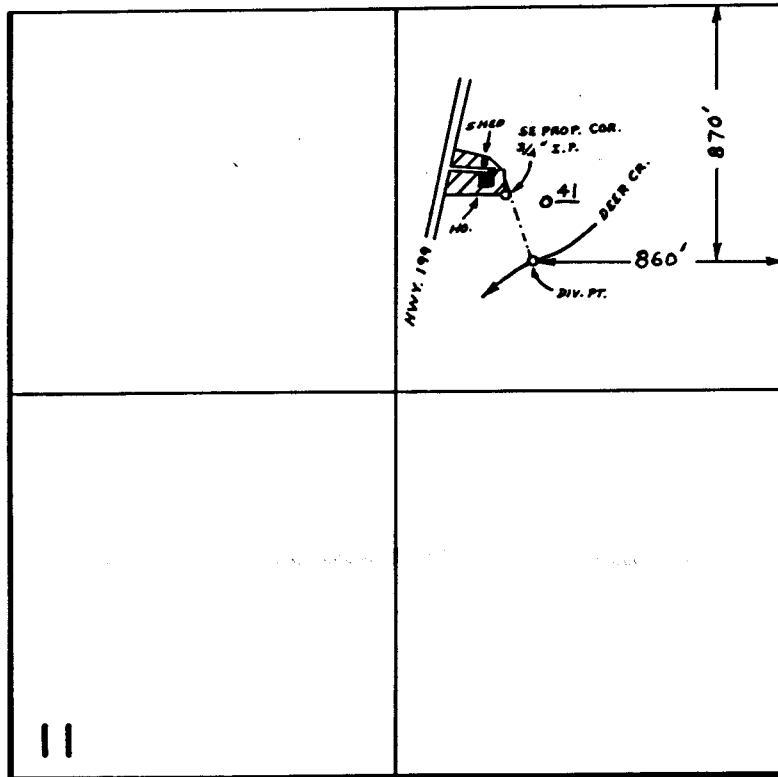

RECEIVED  
JUL 16 1978  
WM. DIST. CLK  
GRANTS PASS, WYO.

SCALE: 1" = 660 FT.

## FINAL PROOF SURVEY UNDER

Application No. 50424 Permit No. 38055  
IN NAME OF

Surveyed JUL. 19 1978, by B. SUND

P.T.S.-1978-14-A