


T.36S., R.5W., W.M.

RECEIVED

JUL 12 1979

WM. DIST. 14
GRANTS PASS

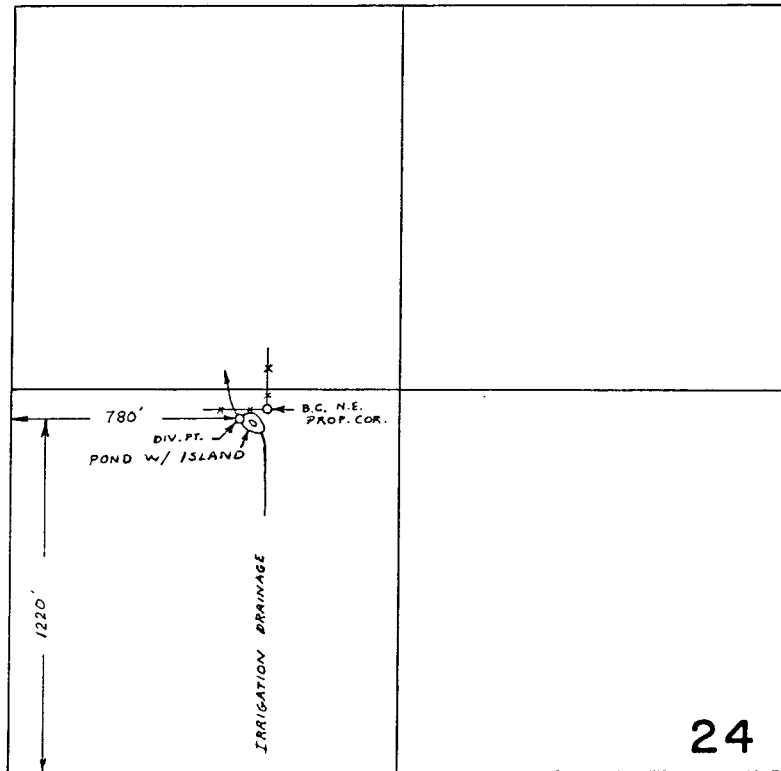

SCALE : 1" = 660 FT.

FINAL PROOF SURVEY
UNDER

53527 38056

Application No. R-53401 Permit No. R-6149
IN NAME OF

WILLIAM O. WILLIAMS

Surveyed JUN. 23 1978, by B. SUND

P.T.S. - 1978-14-A