


Application No. 6129
 Permit No. 3807

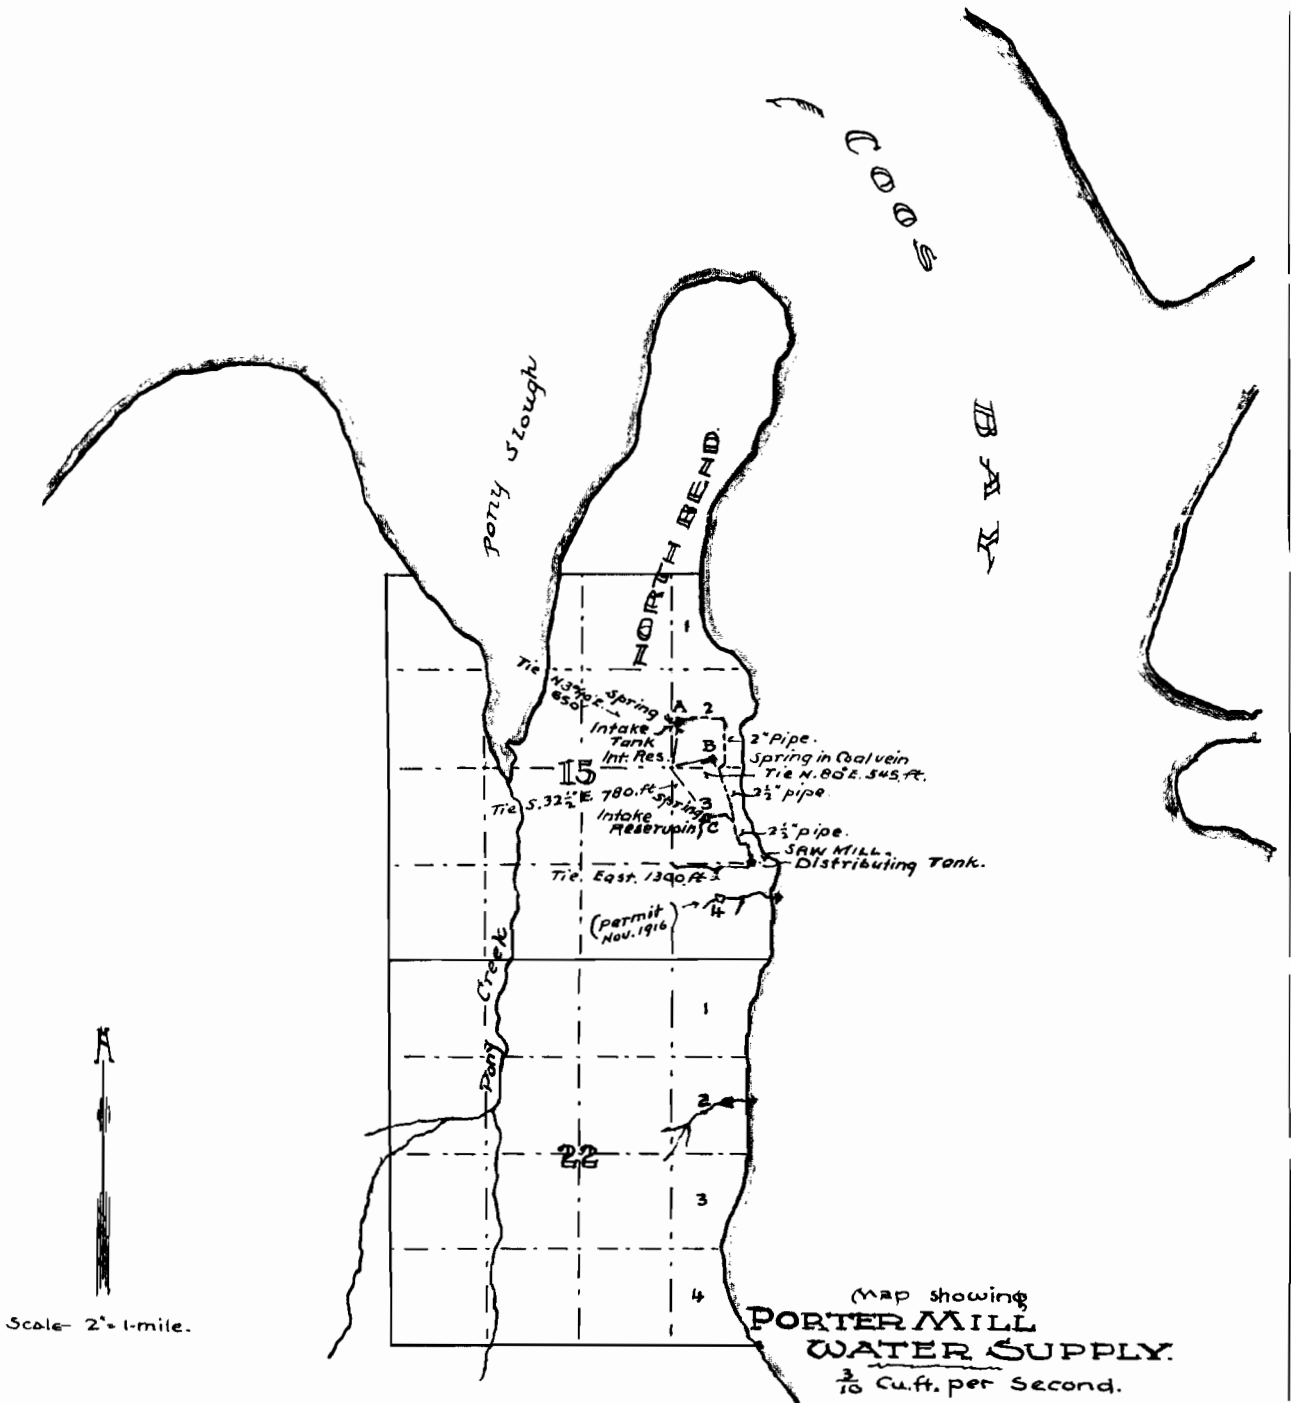

Map showing
**PORTER MILL
 WATER SUPPLY**
 $\frac{3}{10}$ Cuft. per Second.

Certificate of Surveyor.

I, E.L. Robinson, of Marshfield, Ore, do hereby certify that this map is made from notes taken in an actual survey made by me Apr. 29-30, 1918 and that it correctly represents the works and territory described in the accompanying application

Application No. _____
 Permit No. _____
 E.L. Robinson
 Surveyor.

Situated in Lots 2 and 3, Section 15,
 Twp. 25 S., Range 13 W.,
 Will. Mer.,
 Coos County, Oregon.

Buehner Lumber Company,
 Applicant.

To accompany Application for Permit
 to the State Engineer,
 Salem, Oregon.