


RECEIVED  
MAY 17 1973  
STATE ENGINEER  
SALEM OREGON

T. 26 S. R. 6 W.  
1" = 400'

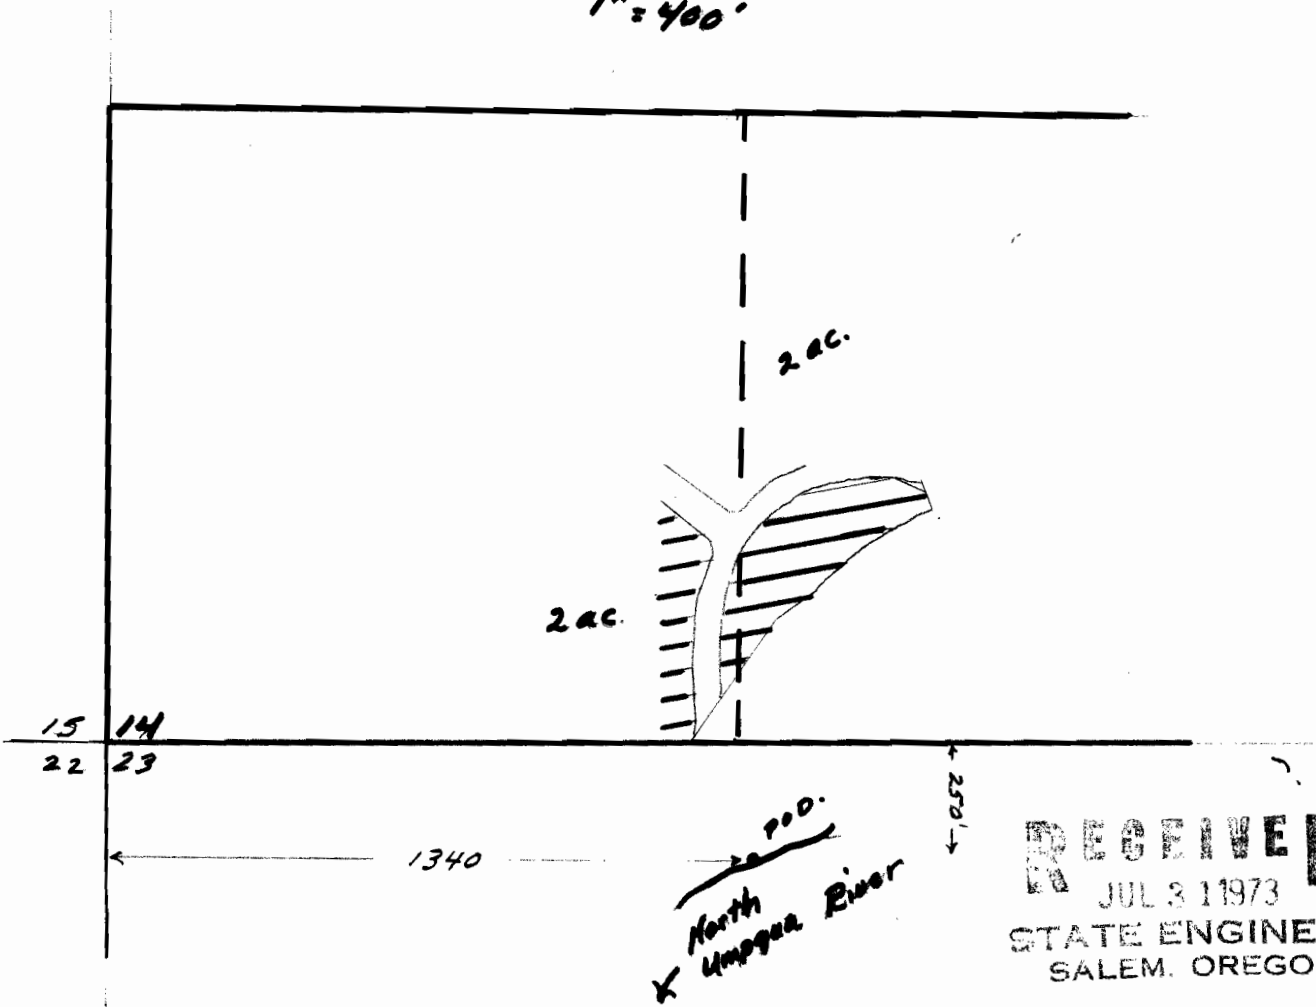

Application No. 50430  
Permit No. 38104