


Application No. 50457
Permit No. 3811

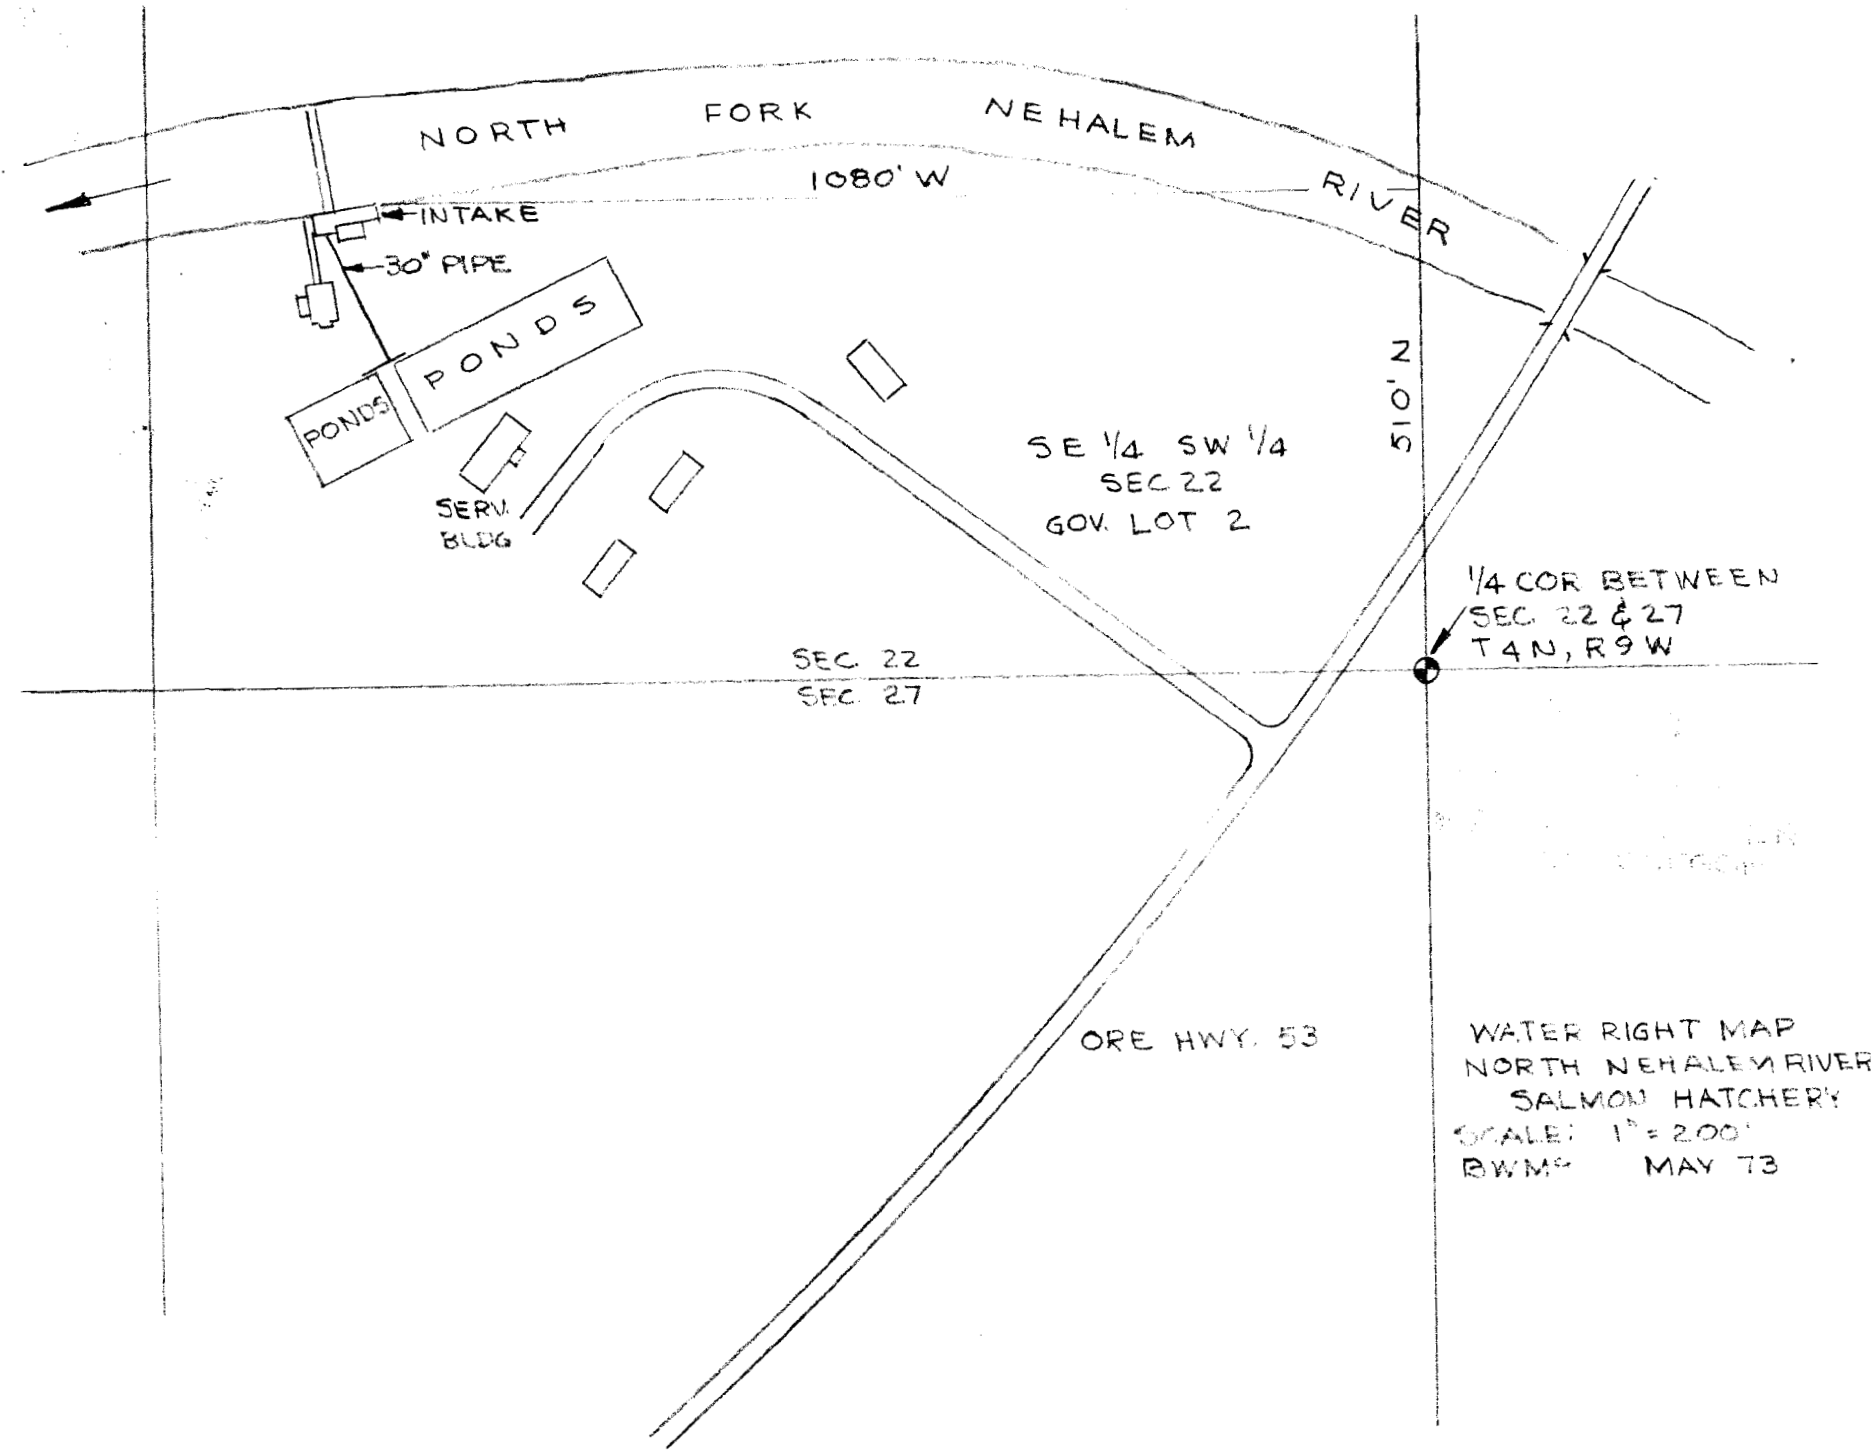

WATER RIGHT MAP
NORTH NEHALEM RIVER
SALMON HATCHERY
SCALE: 1" = 200'
BWM: MAY 73