


Sec. 22, T. 3N., R. 36E. W.M.

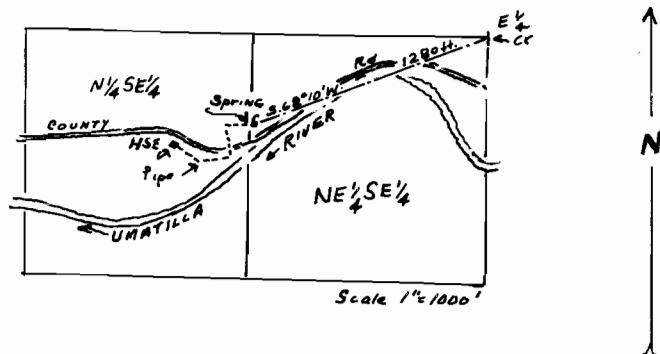

A Map to accompany application for a Spring in the name of Horace V. & Lois H. Livesay of Rt. 1-Box 252, Adams, OR. 97810.

Application No. 50489
Tract No.