

# WATER RIGHT MAP

Oscar C. and Rowena A. Shafer


RECEIVED  
STATE ENGINEER  
SALEM OREGON

## MAP LEGEND

Diversion Point bears 1570'S. & 435'W.  
from NE cor. Sec. 2, T. 2S, R. 44E.



Area to be irrigated

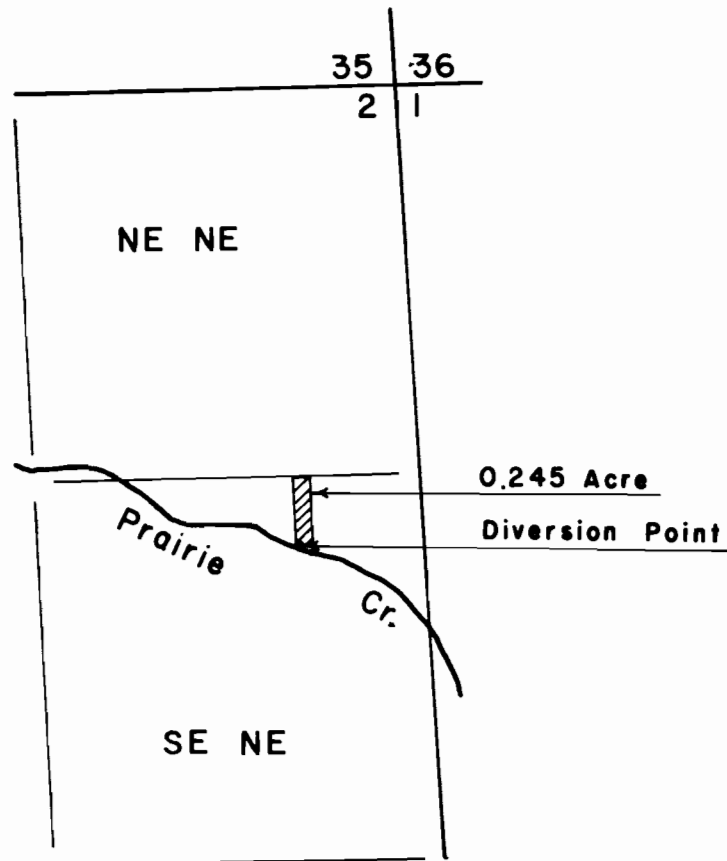

Point 33165

APR 50545