


T. 33 S., R. 6 W., W. M.

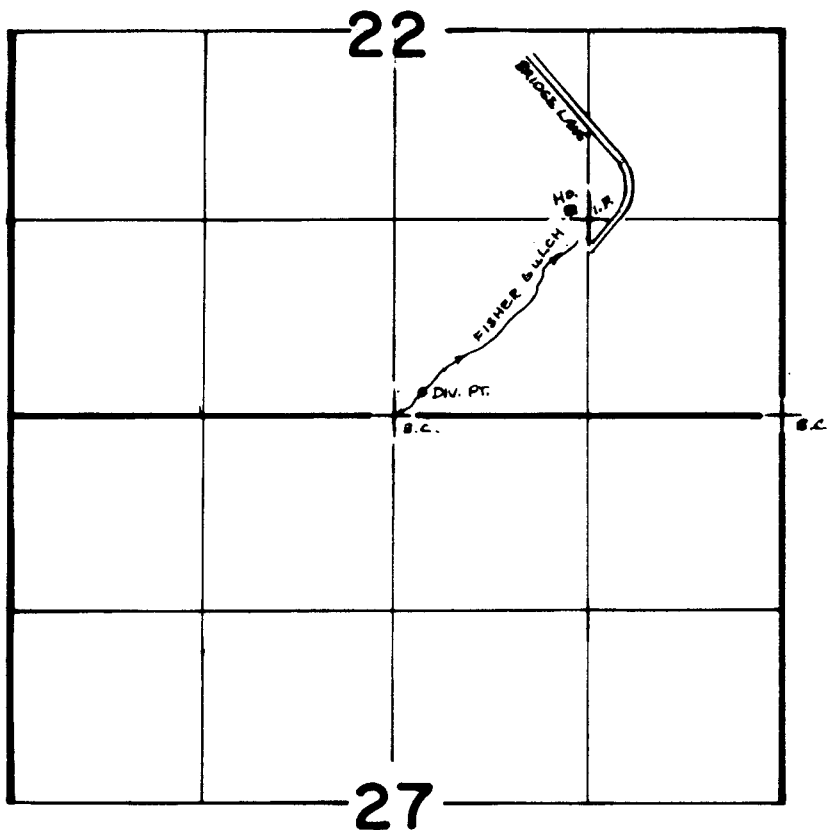

DIV. PT. LOC.: 150' N. & 200' E. FROM 1/4 COR. SEC. 22.

SCALE: 1" = 1320'

FINAL PROOF SURVEY
UNDER

Application No. 50556... Permit No. 38169.....
IN NAME OF

.....CORINNE E. STUMBO.....

Surveyed SEPT. 9 1984, by J.R. WOODROOF.

MAR 24 1988