

Section 35 T 13 S R 31 E W.M.
Grant County

1" = 400'

Section
Corner

26


25

35

36

NW NE

NE NE

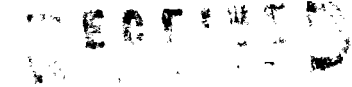

STATE ENGINEER

Application No. 50581

Permit No. 38185

SW NE

SE NE

2720'S

Humbolt St.

Canyon Cr.

NUGGET ST.


House

1/8 acre

Pump

NW SE

2140'W

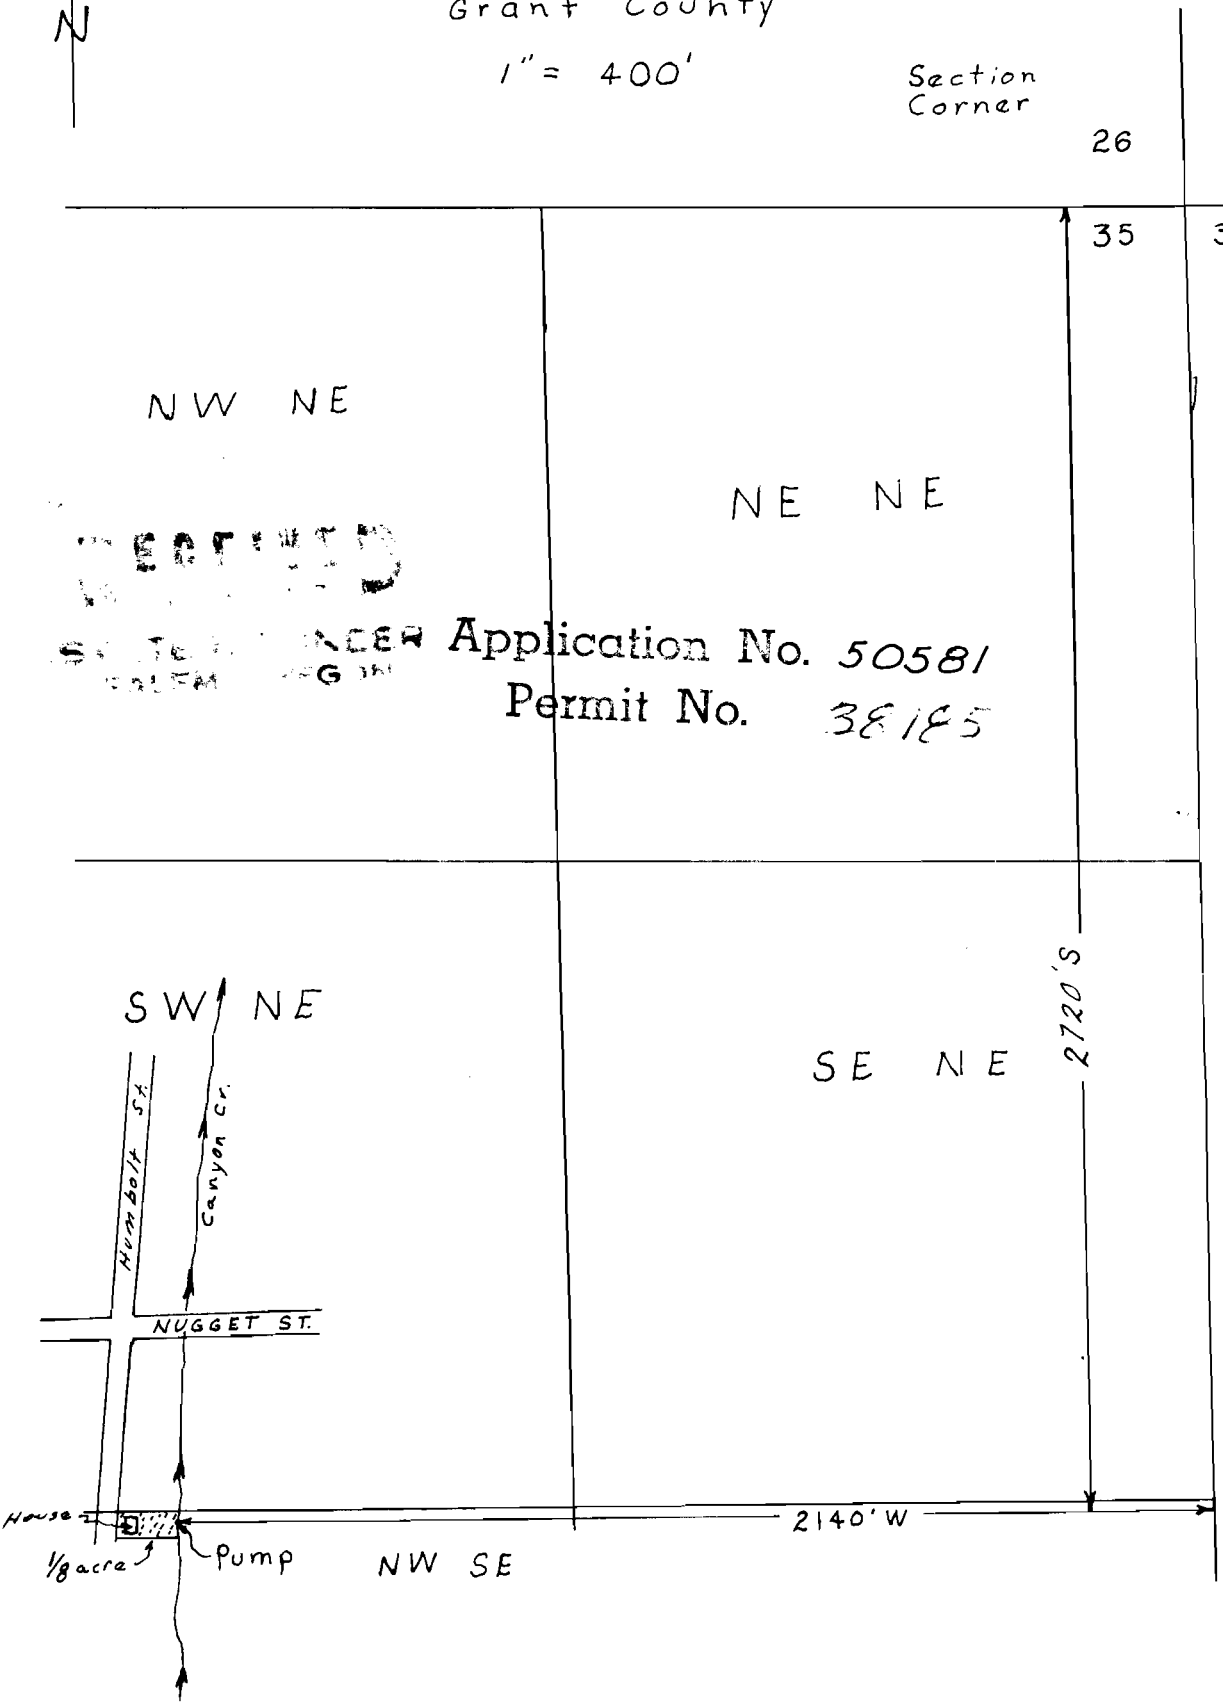


NW 1/4 SE 1/4 Sec. 35 T.13S. R.31 E.
Grant County

RECEIVED
DEC 3 1973
STATE ENGINEER
SALEM, OREGON

Scale 1" = 100'

Application No. 50581
Permit No. Superseded
12-3-73

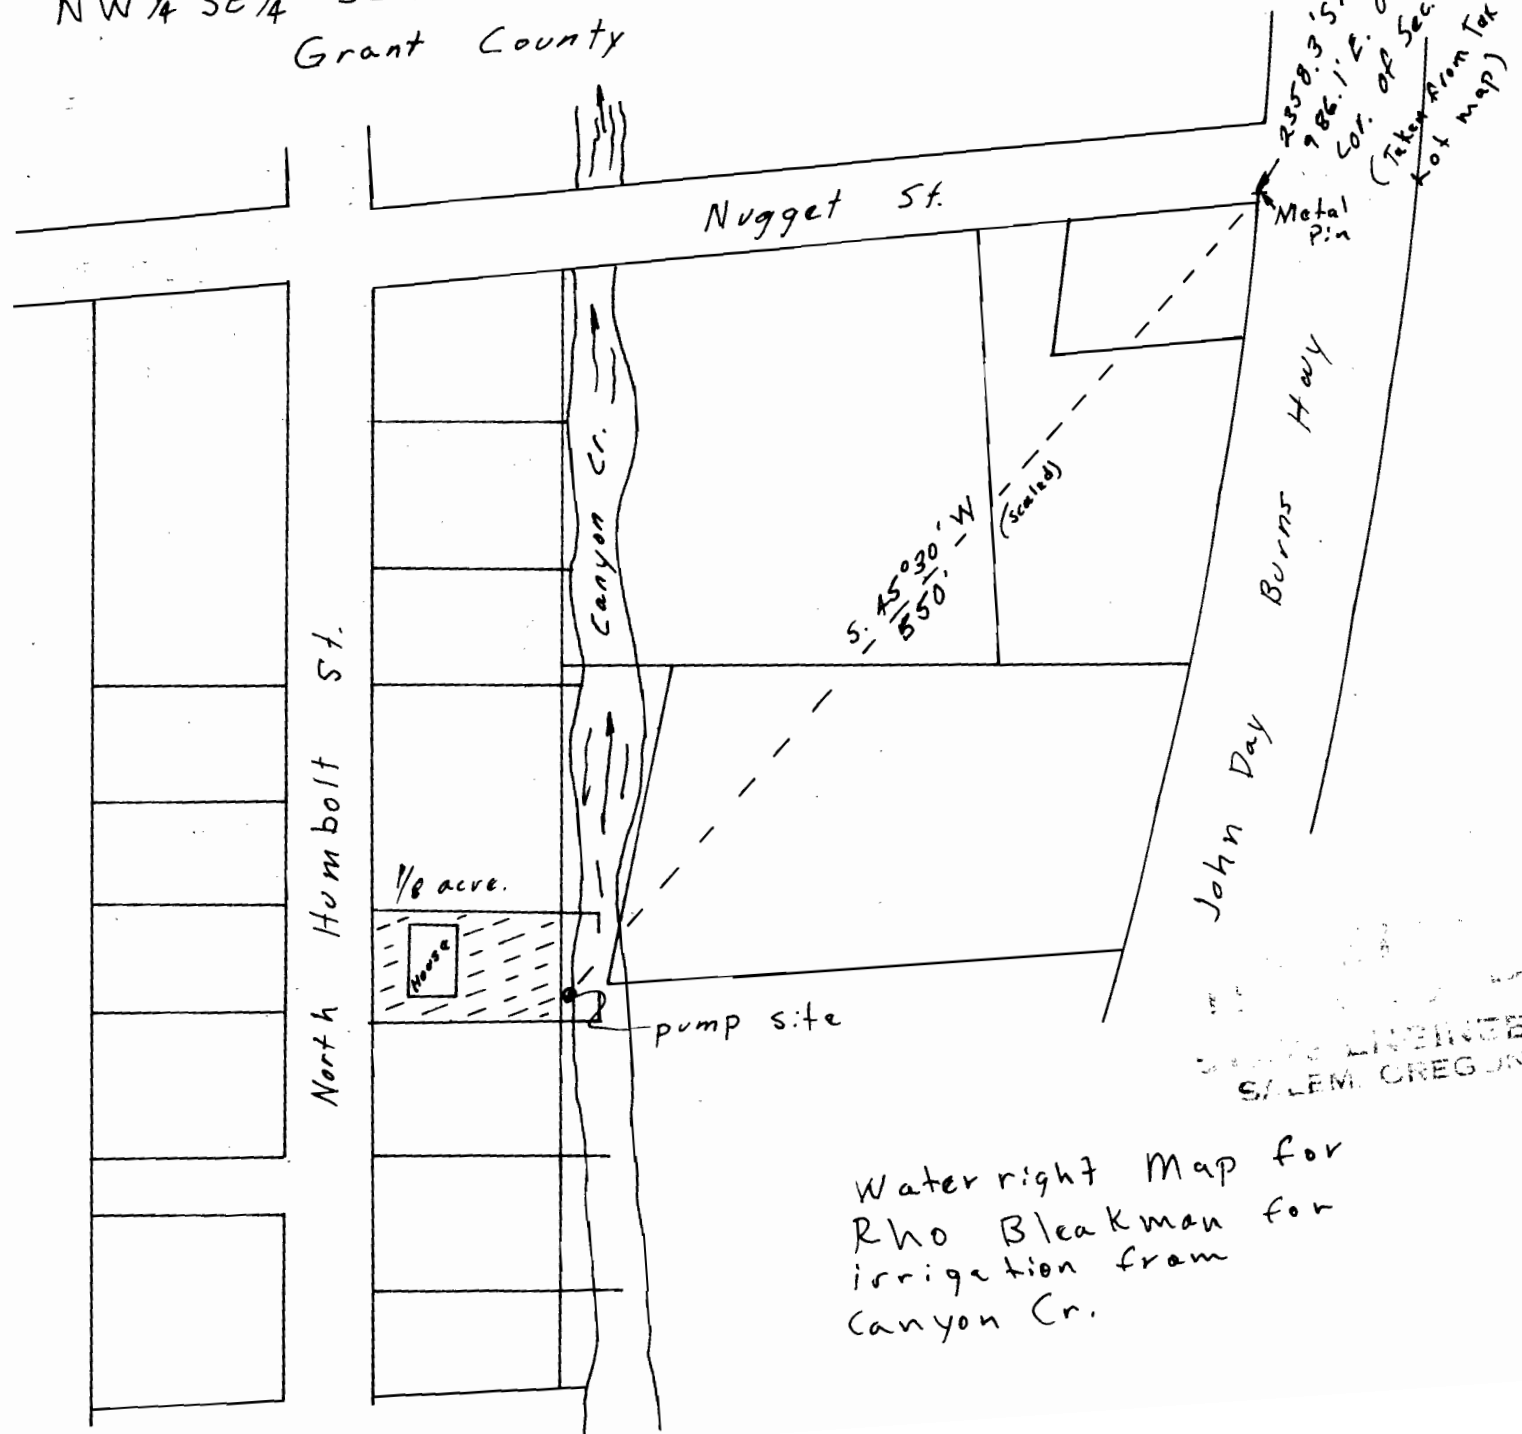

Water right Map for
Rho Bleakman for
irrigation from
Canyon Cr.

STATE ENGINEER
SALEM, OREGON