


Application No. 53537 & G-7070  
 Permit No. 38215 & G5823

JOHN THOMAS  
 16575 SW 85TH  
 TIGARD, OREGON

TOWNSHIP 2 SOUTH, RANGE 1 WEST, W. M.

SECTION 14

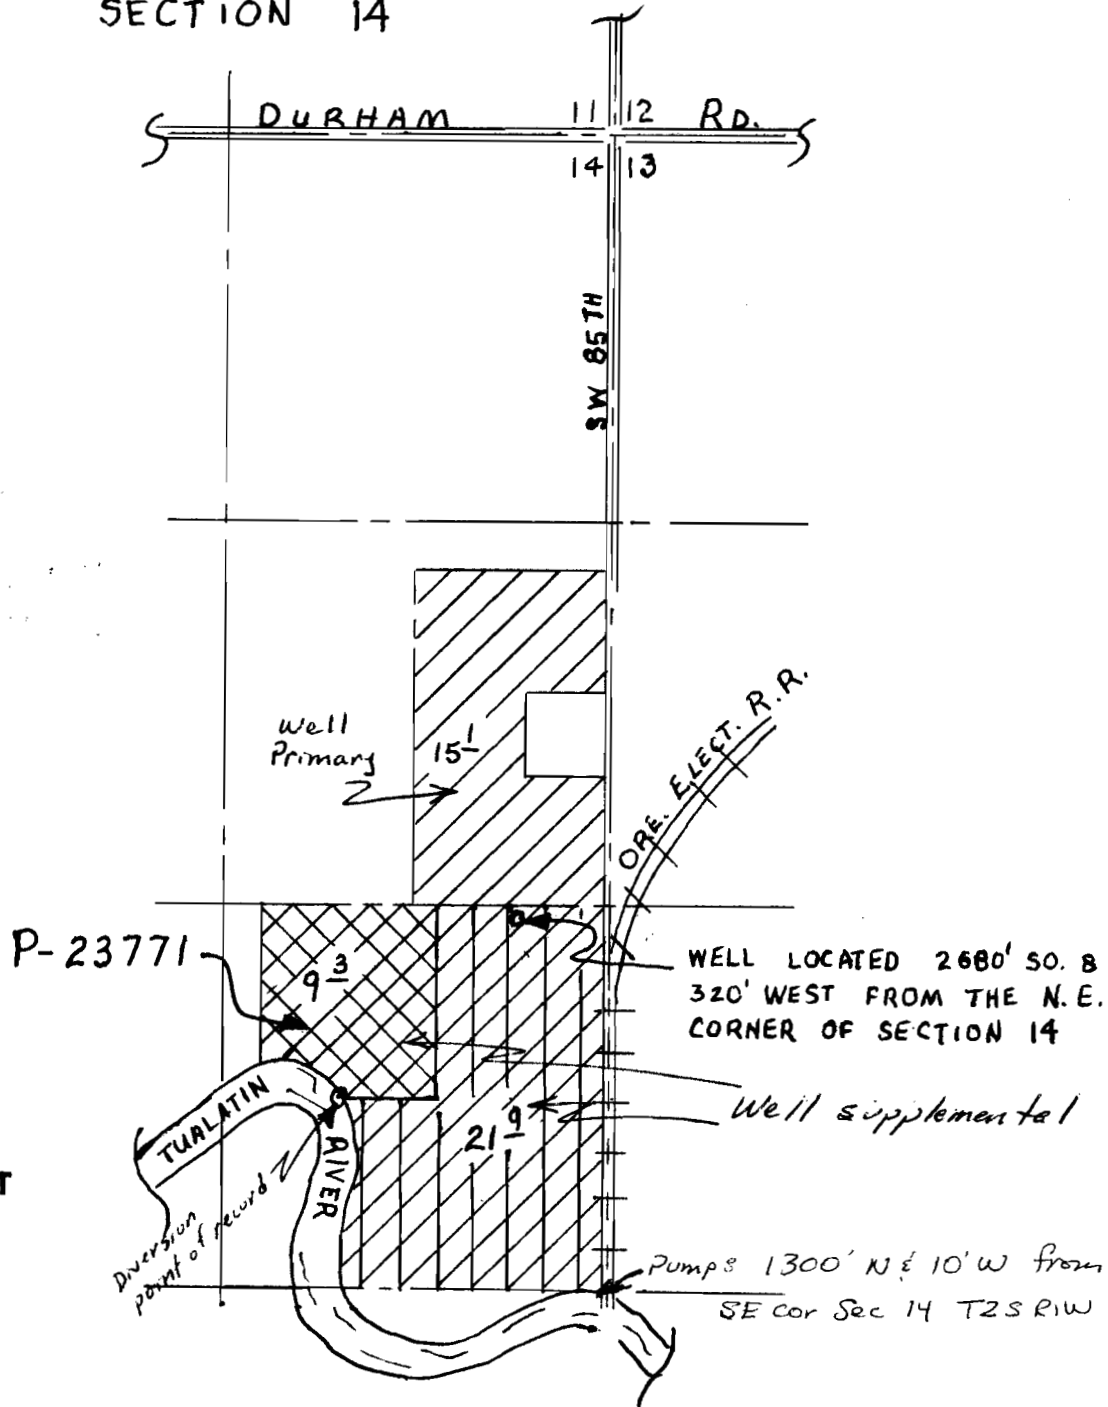

**RECEIVED**

AUG 14 1975

WATER RESOURCES DEPT  
 SALEM, OREGON

SCALE: 1" = 660 FT.