

Donald R. Grubbs


P.38271

Application No. 50657

Permit No. 38271

Priority 6-13-73

Find in Elk Creek

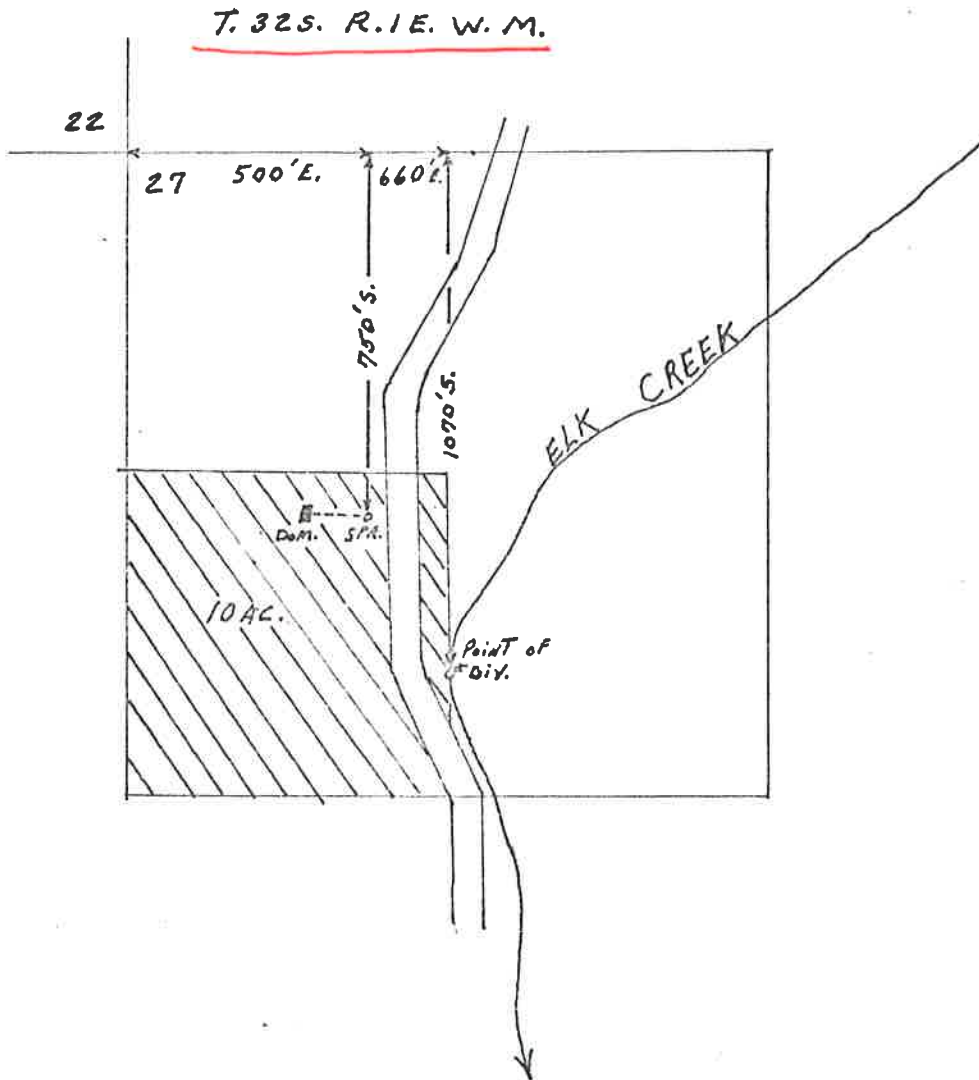

MAP TO ACCOMPANY APPLICATION OF DONALD R. GRUBBS FOR IRRIGATION AND DOMESTIC.



SCALE 1" = 400'

6-5-73