


Section 18 T.16 S. R.8W.W.M.
 LANE COUNTY
 1"=400'

FOR ASSESSMENT
 AND TAXATION
 USE ONLY

16 08 18

4-25-90
 -CORE DIM. ON BASSONETTE
 -ADD RD. STATIONING AT
 INTERSECTION

See Map 16 08 07

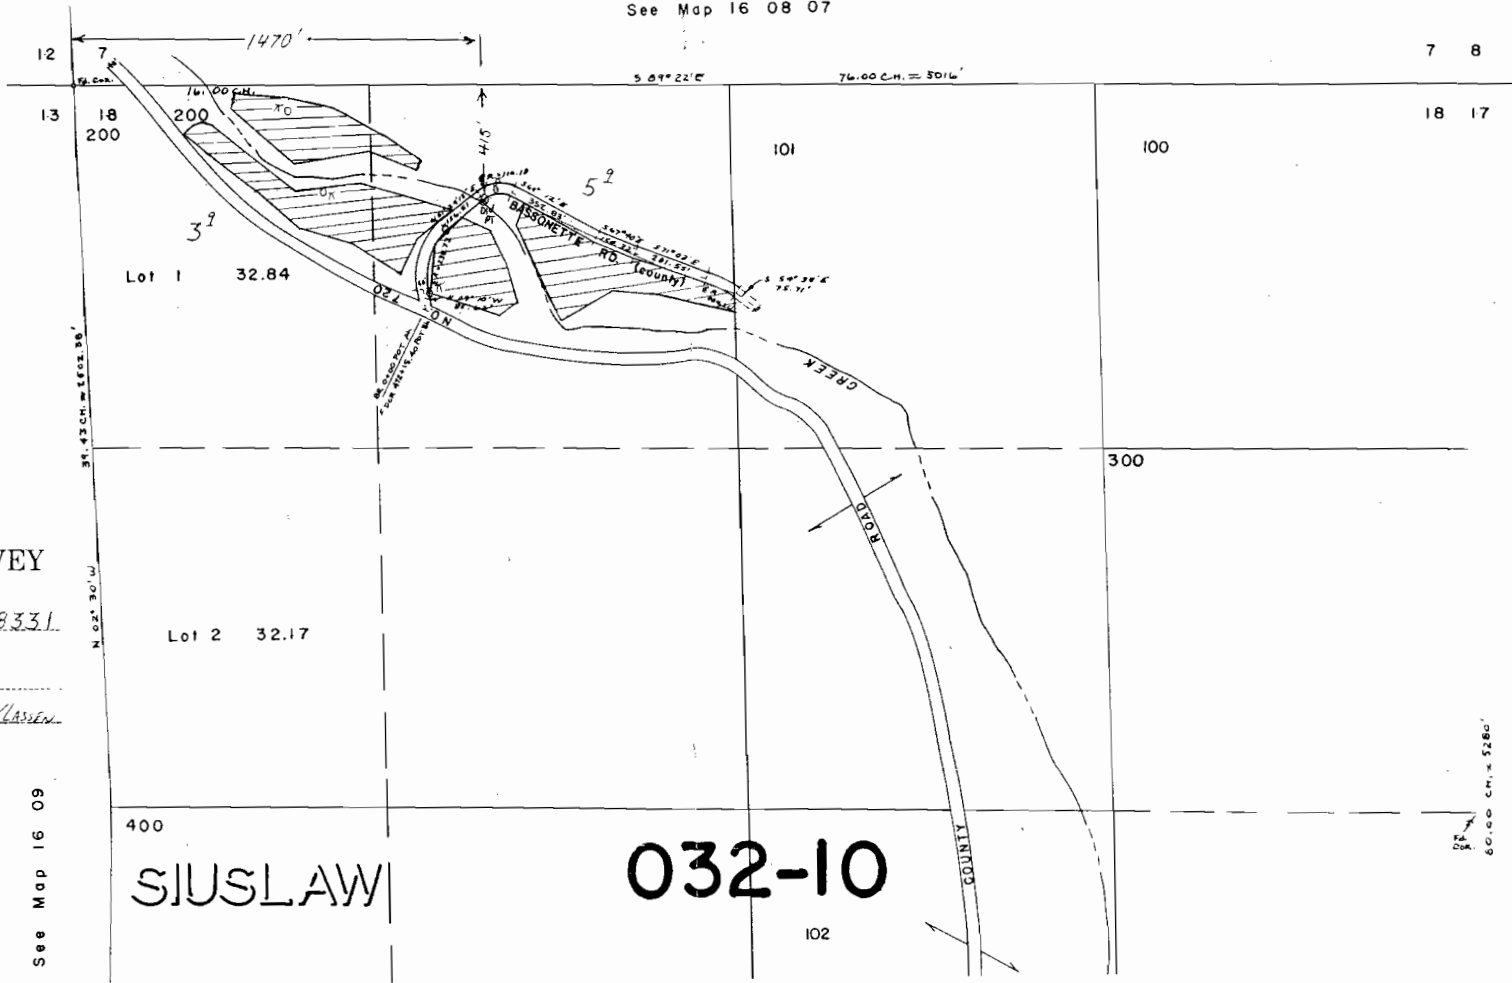

N 933,948
 E 1,167,419

7 8
 18 17
 0 32,291,11 3
 N 933,690
 E 1,167,419

FINAL PROOF SURVEY

UNDER

Application No. 50754 Permit No. 38331

IN NAME OF

CHARLES BADER

Surveyed June 18 19 91, by R.V. Klassen

See Map 16 09

SIUSLAW

032-10

102

60.00 C.M. x 5280'