


38341

RECEIVED

SEP 5 1978

WM. DIST. 14  
GRANTS PASS, ORE

T.37S., R.7W., W.M.

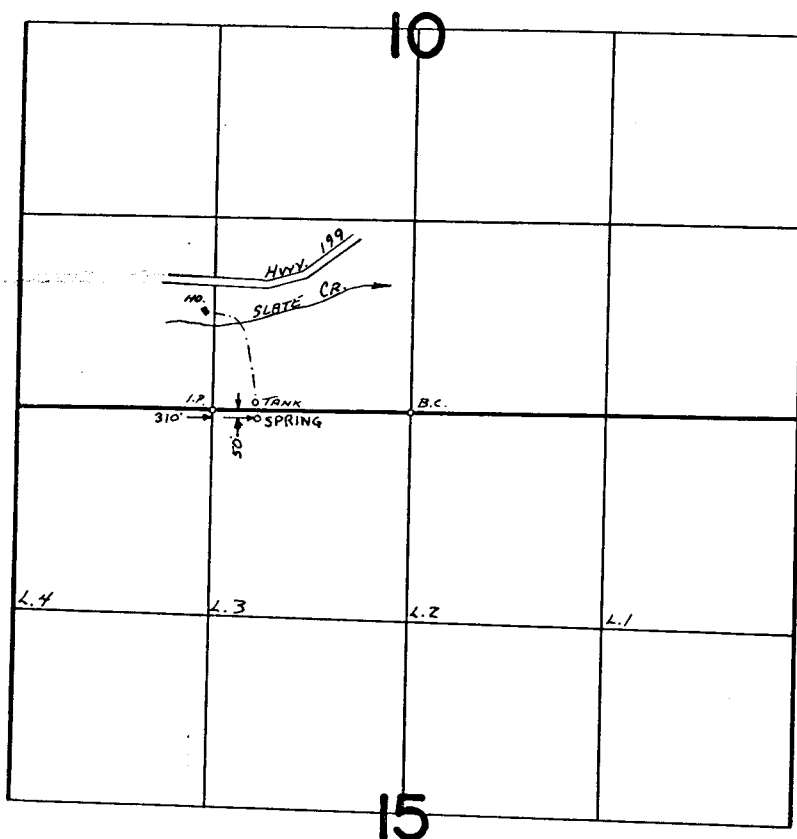

**FINAL PROOF SURVEY**  
UNDER

Application No. 50770 Permit No. 38341  
IN NAME OF

WILLIAM E. MALLEY

Surveyed MAY 4 1976, by L. TOLL

PT5 1976-U