


WATER RIGHT MAP

FOR: WALT ERDMAN
RT. 1, BOX 59
HILLSBORO, ORE.

TOWNSHIP 1 SOUTH, RANGE 3 WEST, W.M.

SECTION 12

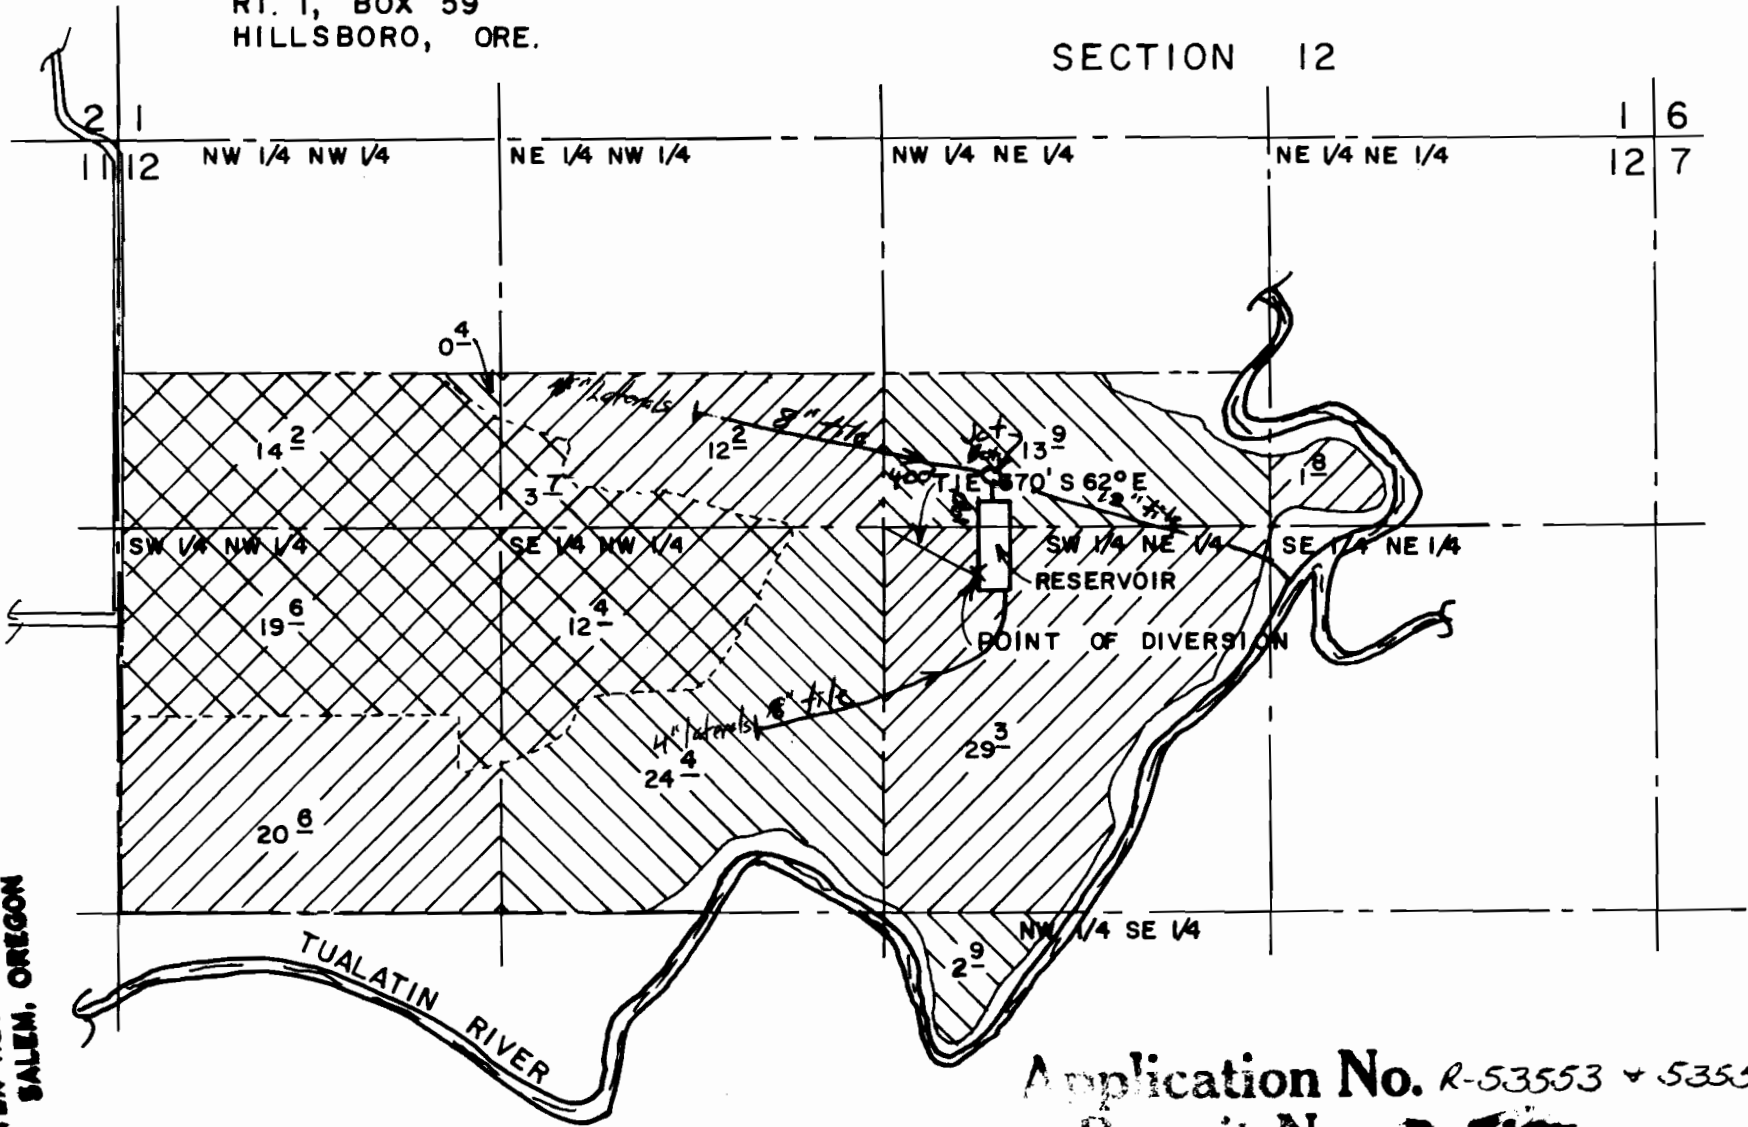

RECEIVED

AUG 18 1975

WATER RESOURCES DEPT
SALEM, OREGON



AREA #1 = 50⁵ ACRES *not included in this project*



AREA #2 = ~~104~~ ACRES 105.5

Application No. R-53553 + 53554

Permit No. R 6195 38413