


T. 26 S., R. 6 W., W.M.

SEC. 28 & 33

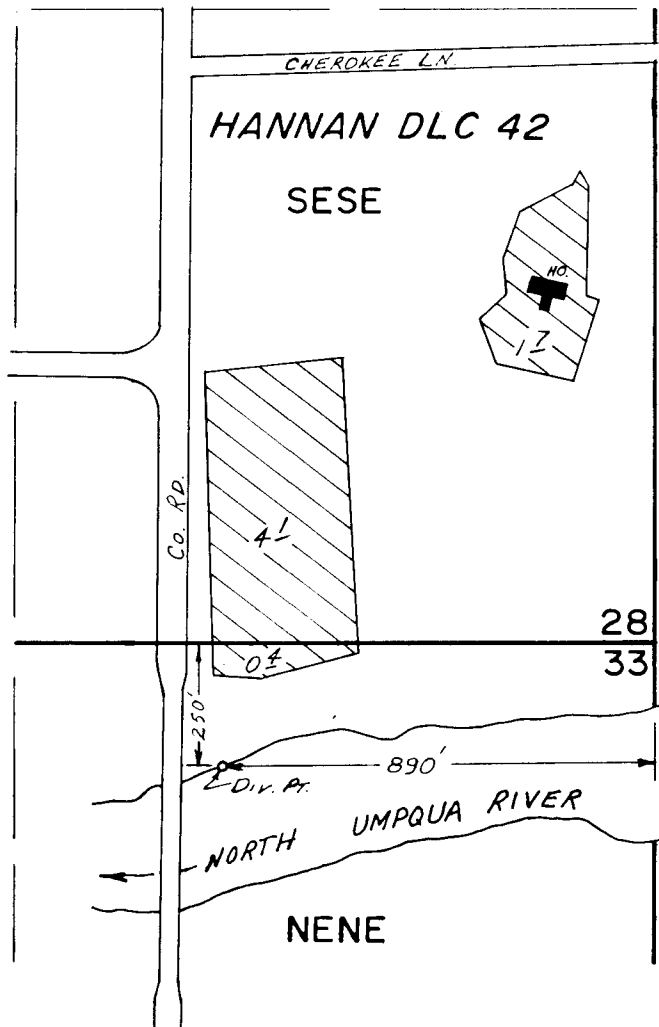

FINAL PROOF SURVEY
UNDER

Application No. 50952... Permit No. 38464.....
IN NAME OF

.....**ALLYN C. FORD**.....

Surveyed ..AUG. 11... 1982., by L. M. TOLL.....