


T. 37 S., R. 8 W., W.M.

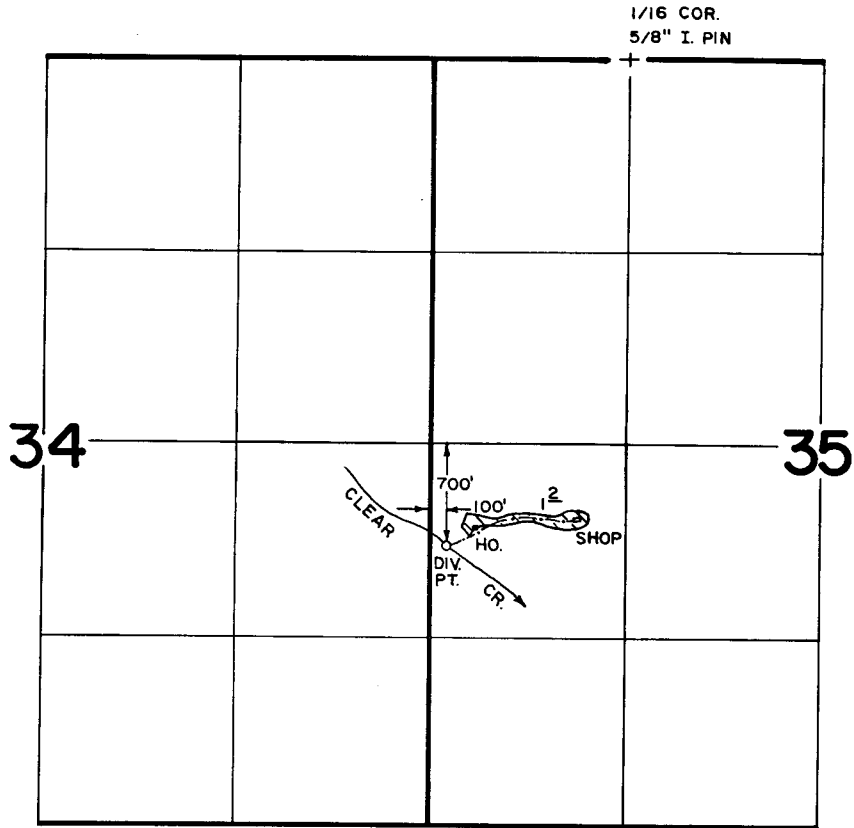

FINAL PROOF SURVEY

UNDER

MAR 25 1988

1961 DIST. 14
GRANTS PASS, ORG.

Application No. 50998 Permit No. 38493
IN NAME OF

JONAS LOHR

Surveyed OCT. 26 1983, by B. S. JAMES.....

Scale: 4" = 1 Mile

179-195L TWB