


T.36 S., R.7 W., W.M.

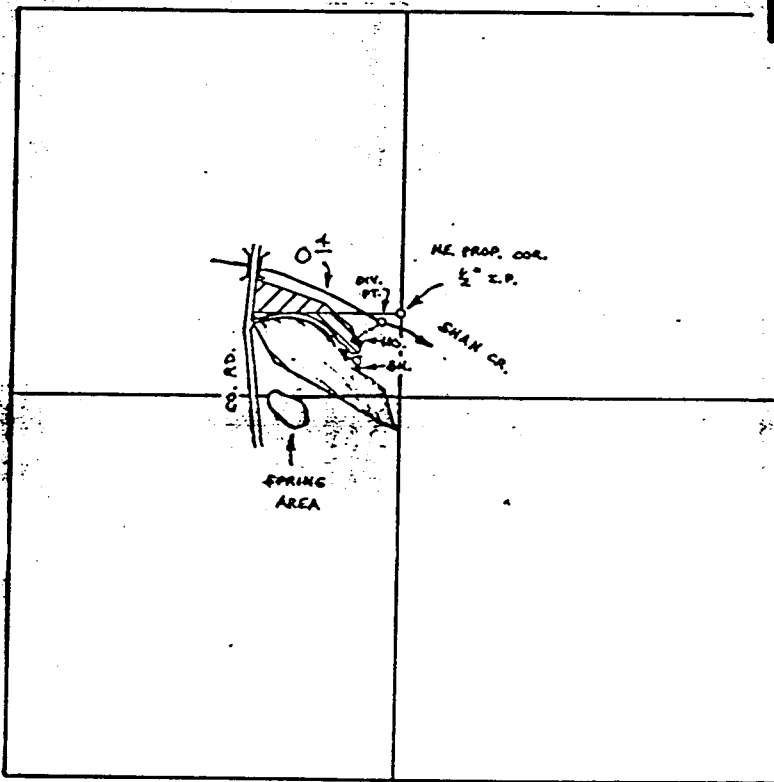

RECEIVED

MAR 6 1991

WM. DIST. 14
GRANTS PASS, ORE.

DIV. PT. LOC.: 1060' S. & 1250' E.,
FROM W. 1/4 COR., SEC. 11.

SCALE: 1" = 660 FT.

FINAL PROOF SURVEY
UNDER

51002

38496

50119

37661

Application No. 50704 Permit No. 38297

IN NAME OF

MARTIN C. HOLK

Surveyed NOV. 14 1977, by B. SUND



D.H.M.

P.T.S. - 1977 - 14 - B