


T.37S.,R.6W.,W.M.

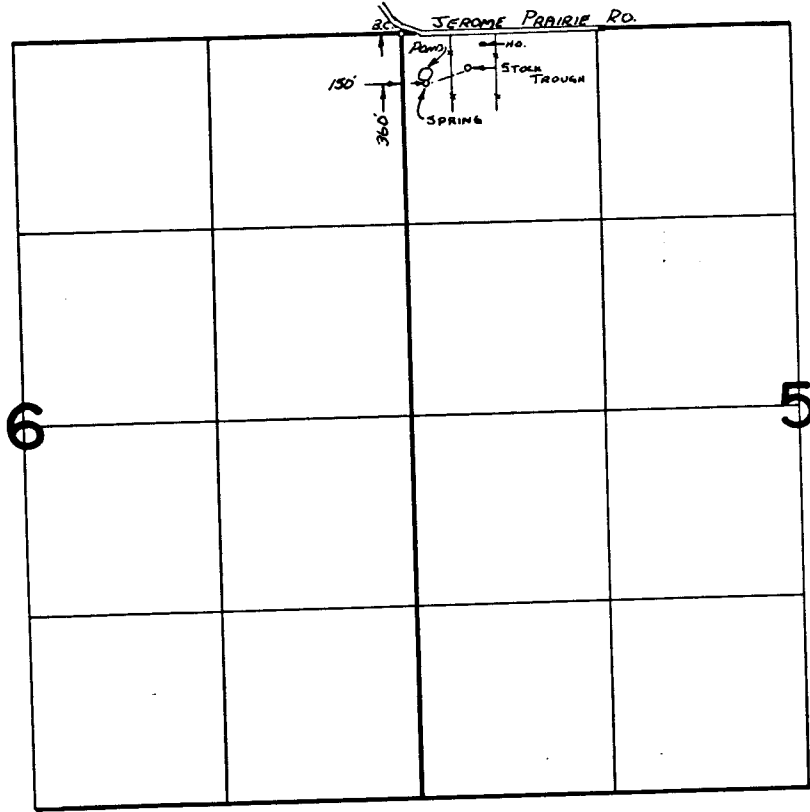

FINAL PROOF SURVEY
UNDER

RECEIVED

AUG 8 1978

WM. DIST. 14
GRANTS PASS. ORE.

Application No. 51026 Permit No. 38512
IN NAME OF

LILLIAN A. SMITH

Surveyed MAY 4 1976, by L. TOLL

PTS 1976-U