



T.37S., R.6W., W.M.

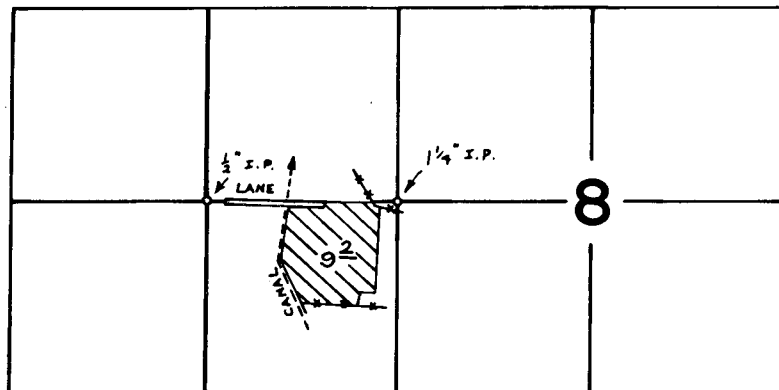

RECEIVED
JUL 15 1980
W.M. DIST. 14
GRANTS PASS, ORE

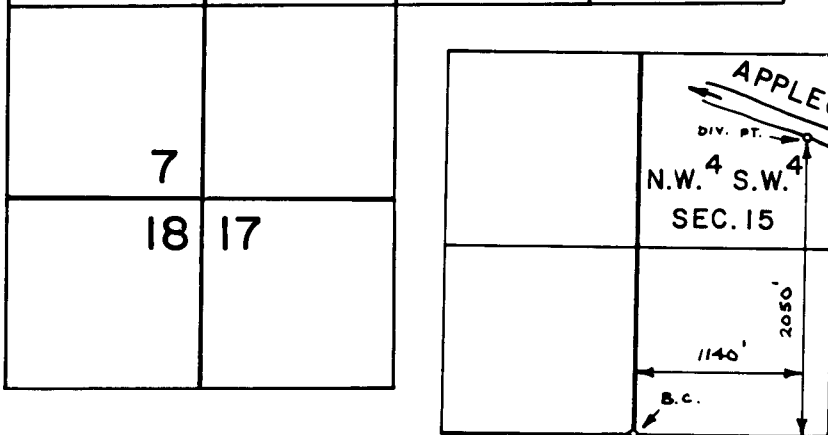

FINAL PROOF SURVEY

UNDER

6.1 20 77

Application No. 53095 Permit No. 38582

IN NAME OF

JAMES L. ROBINSON

Surveyed OCT. 12 19 77, by B. SUND

D.H.M.
P.T.S. - 1977-14-B